



MARGARET MAYTON AVENUE

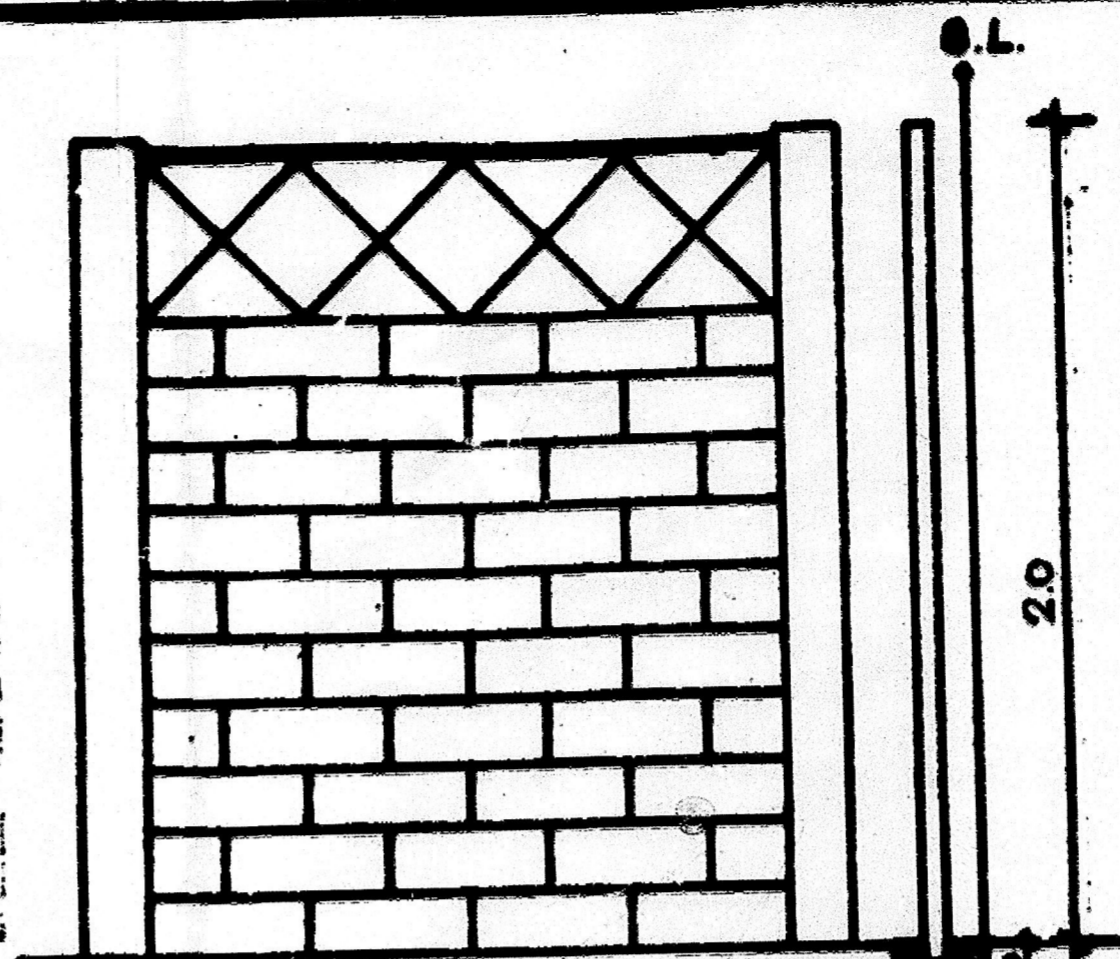

Portion of post in concrete mix below ground level

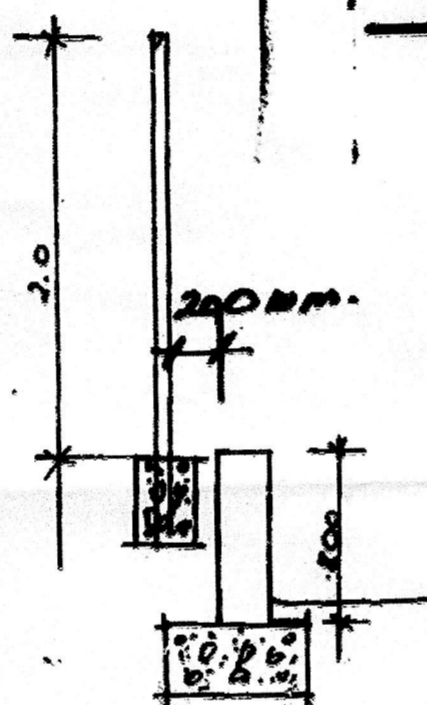

SECTION X-X and Y-Y
(1:50)

Any person undertaking building operations in accordance with this plan is required to ascertain from the City Electrical Engineer the location of underground cables in the vicinity of the proposed wall prior to the commencement thereof.

SHEET	1/1	COPY	1
CITY OF DURBAN			
PLAN No. 1019/6/83		APPROVED	
		DATE	1983. 7. 22.
E.C. MACLEOD		<i>[Signature]</i>	
CITY ENGINEER			

ORIGINAL AS BUILT

[Signature]
25/4/83

NOTES			
FOUNDATIONS NOT TO ENCROACH OVER BOUNDRIES.			
NOT TO RETAIN MORE THAN 300mm SOIL.			
FAIR FACE TO FACE ROAD STREET.			
WALLING DETAILS			
	HEIGHT	LENGTH	DESIGN
A - B	2.0	15.0	RUSTIC
B - C	2.0	5.0	..
C - D	2.0	10.0	..
D - E			
E - F			
F - G			
G - H			
H - I			

SCALE : 1 : 500

SITE DESCRIPTION: SUB 244 OF VIRGINIA N^o 13816

PROPOSED PRECAST WALL FOR Mr. D. ROSY

73 MARGARET MAYTON AVE.

NATAL CONCRETE WALLS

P.O. Box 22012, GLENASHLEY, 4022

Phone 524521-524522.

DRG. No. 1378/19

DATE 20:6:83.

[Signature]