



EAST ELEVATION

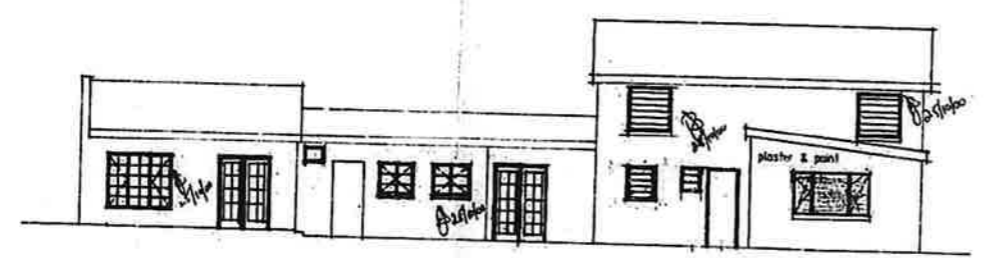


SOUTH ELEVATION

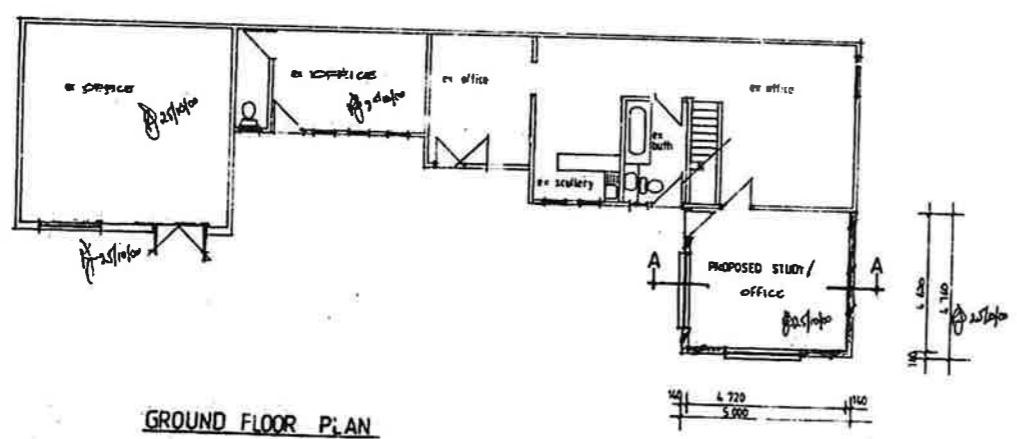


GROUND FLOOR PLAN


PROP STUDY 21m²
SITE AREA: 1199m²
EX. BLDG

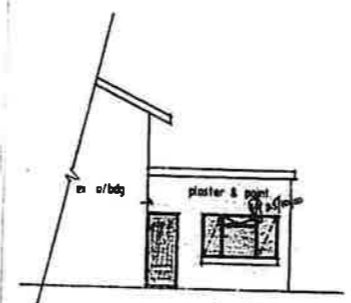

West ELEVATION

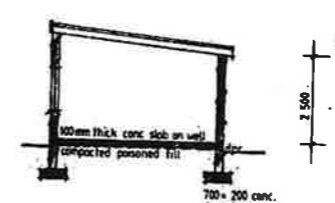

SECTION A-A

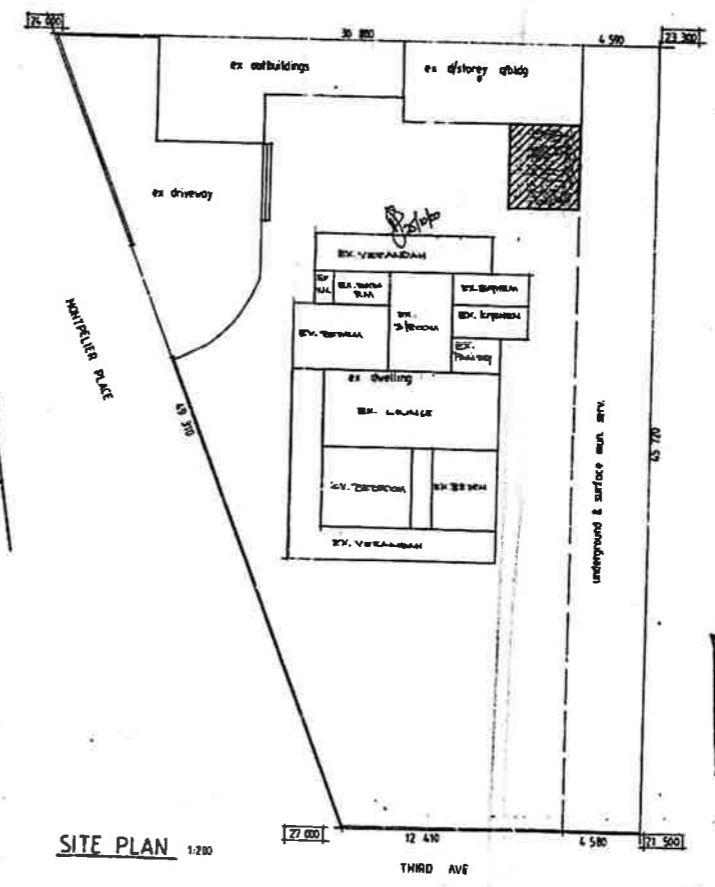

SITE PLAN 1:200

SHEET 1 OF 1
CITY OF DURBAN
PLANNING
0269-04-09-7

SITE INSPECTION IN ORDER
D. R. [Signature]
S. R. I.
DATE 15/11/00

ESSENTIAL SERVICES
All services required for the development must be provided in accordance with the relevant legislation and regulations. The applicant must provide a copy of the relevant legislation and regulations to the City Engineer. The City Engineer will advise the applicant of the requirements for the services to be provided. The applicant must provide a copy of the relevant legislation and regulations to the City Engineer. The City Engineer will advise the applicant of the requirements for the services to be provided.

PROPOSED STUDY FOR
MR C PEARSON ON BEHALF OF Pearsons Pty LTD
LOT 943 DURBAN
38 MONTPELIER PLACE
MORNINGSIDE DURBAN

Contact: 303 1310

SUBDIVISIONS
DIVISION
SITEPLAN CHECKED
1999-04-16

SCALE: 1:100 1:200
DATE: APRIL '99
DRAWN BY: A O'REILLY
9 POHSETTIA RD
GLEN HILLS
4051

OWNER'S SIGNATURE:

[Signature]

