



LOCALITY PLAN

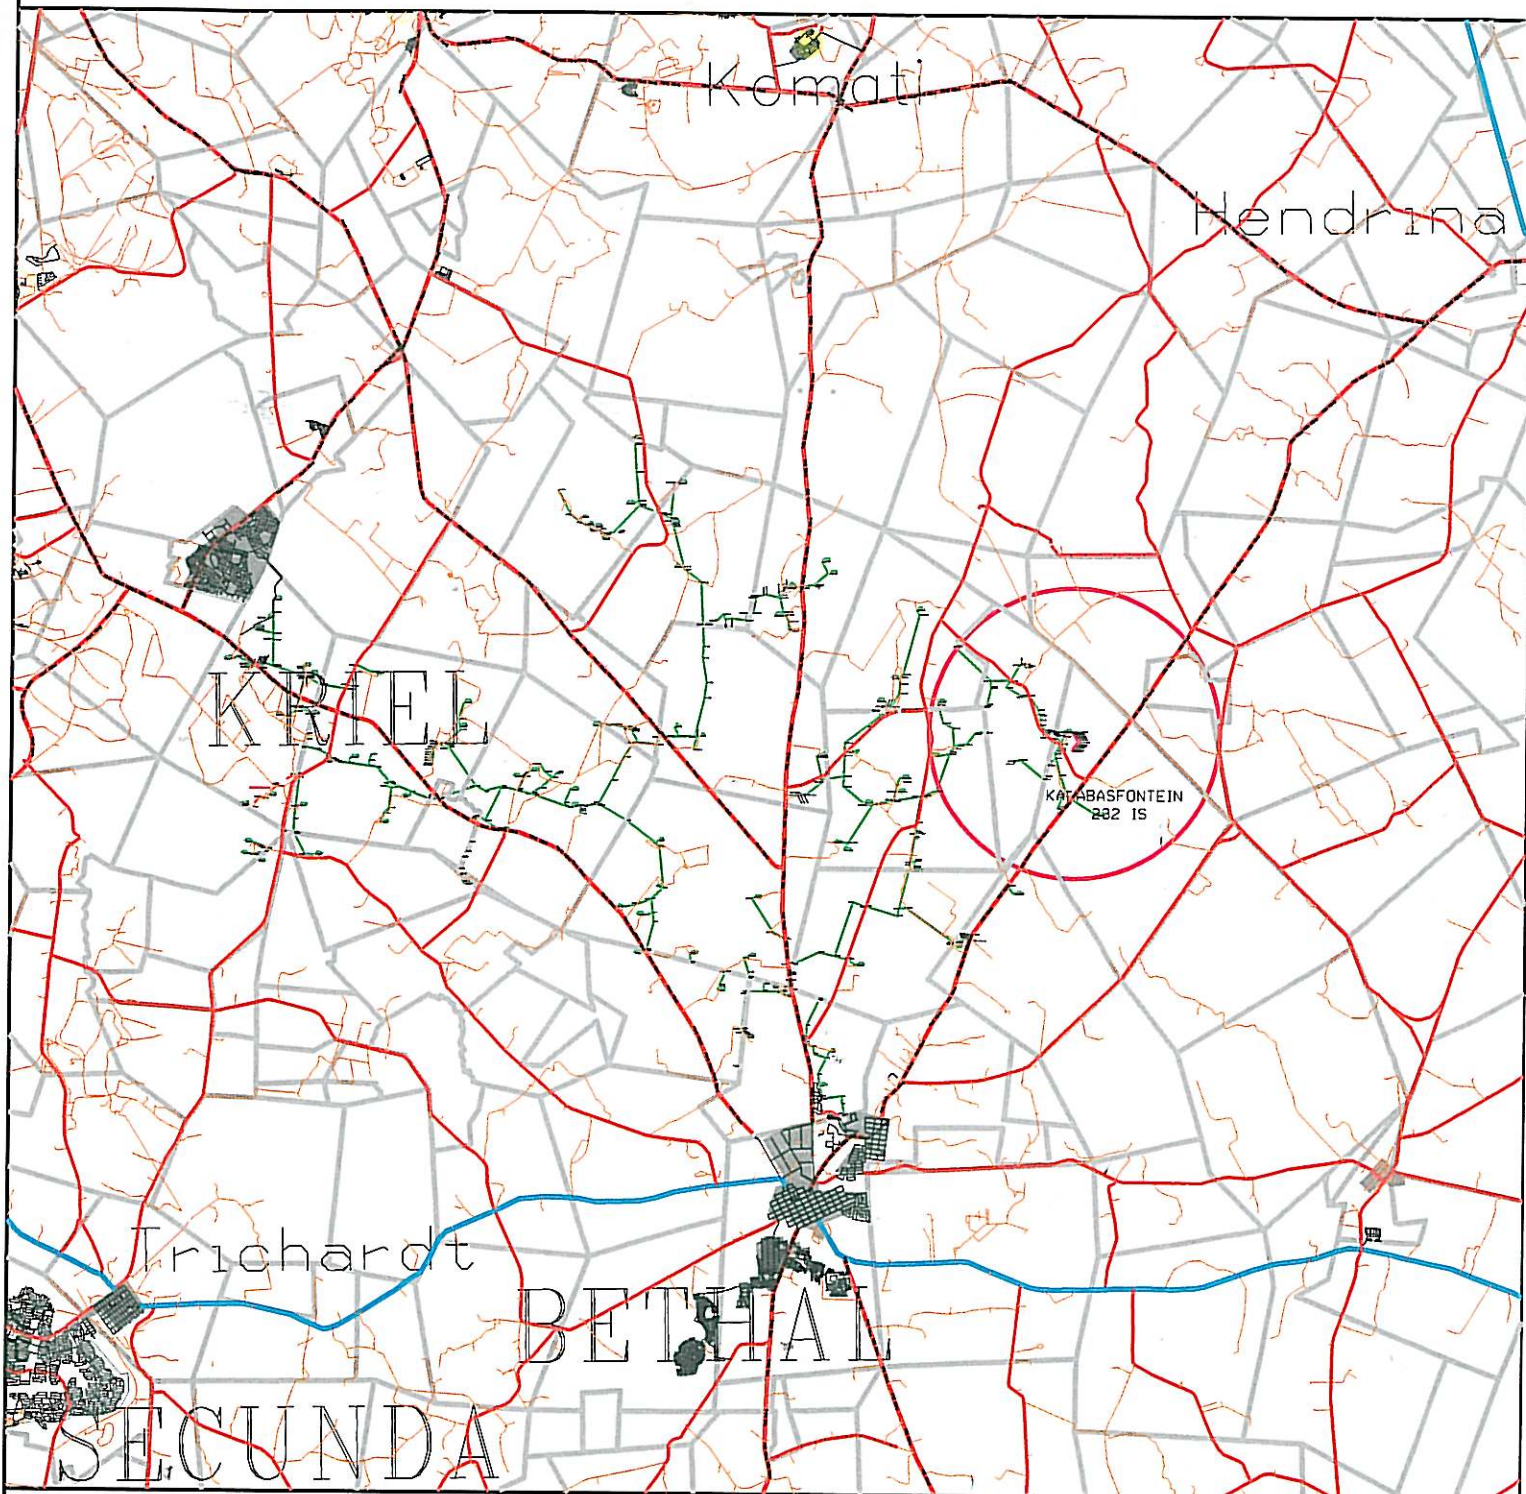

 Disclaimer  
 Geographic Mapping Witbank  
 are not responsible for any errors  
 in external datasets displayed on this map



COORDINATE SYSTEM: LO84/29

SCALE 1:250 000

Information from official maps reproduced under Government printers copyright authority No. 4139 of 28/03/1969



Mpumalanga Operating Unit  
 Land Development

P.O.Box 223  
 Witbank 1035  
 Tel 013 - 693 3121  
 Fax 013 - 693 3261

Feeder:	BETHAL-BETHAL NORTH 11KV	Surveyor:	
Customer:	KALABASFONTEIN VILLAGE	Geographic mapping:	C.FOUIRE
Project No:	SURVEY OF AS BUILT LINES	Date compiled:	
Portion of map no:		T-OFF POLE COORD:	29° 33' 27.6" E 26° 18' 33.9" S
Page:	1 of 3	Revised by:	
		Revision date:	