


DASHED RED LINE INDICATES POWERLINE ROUTE

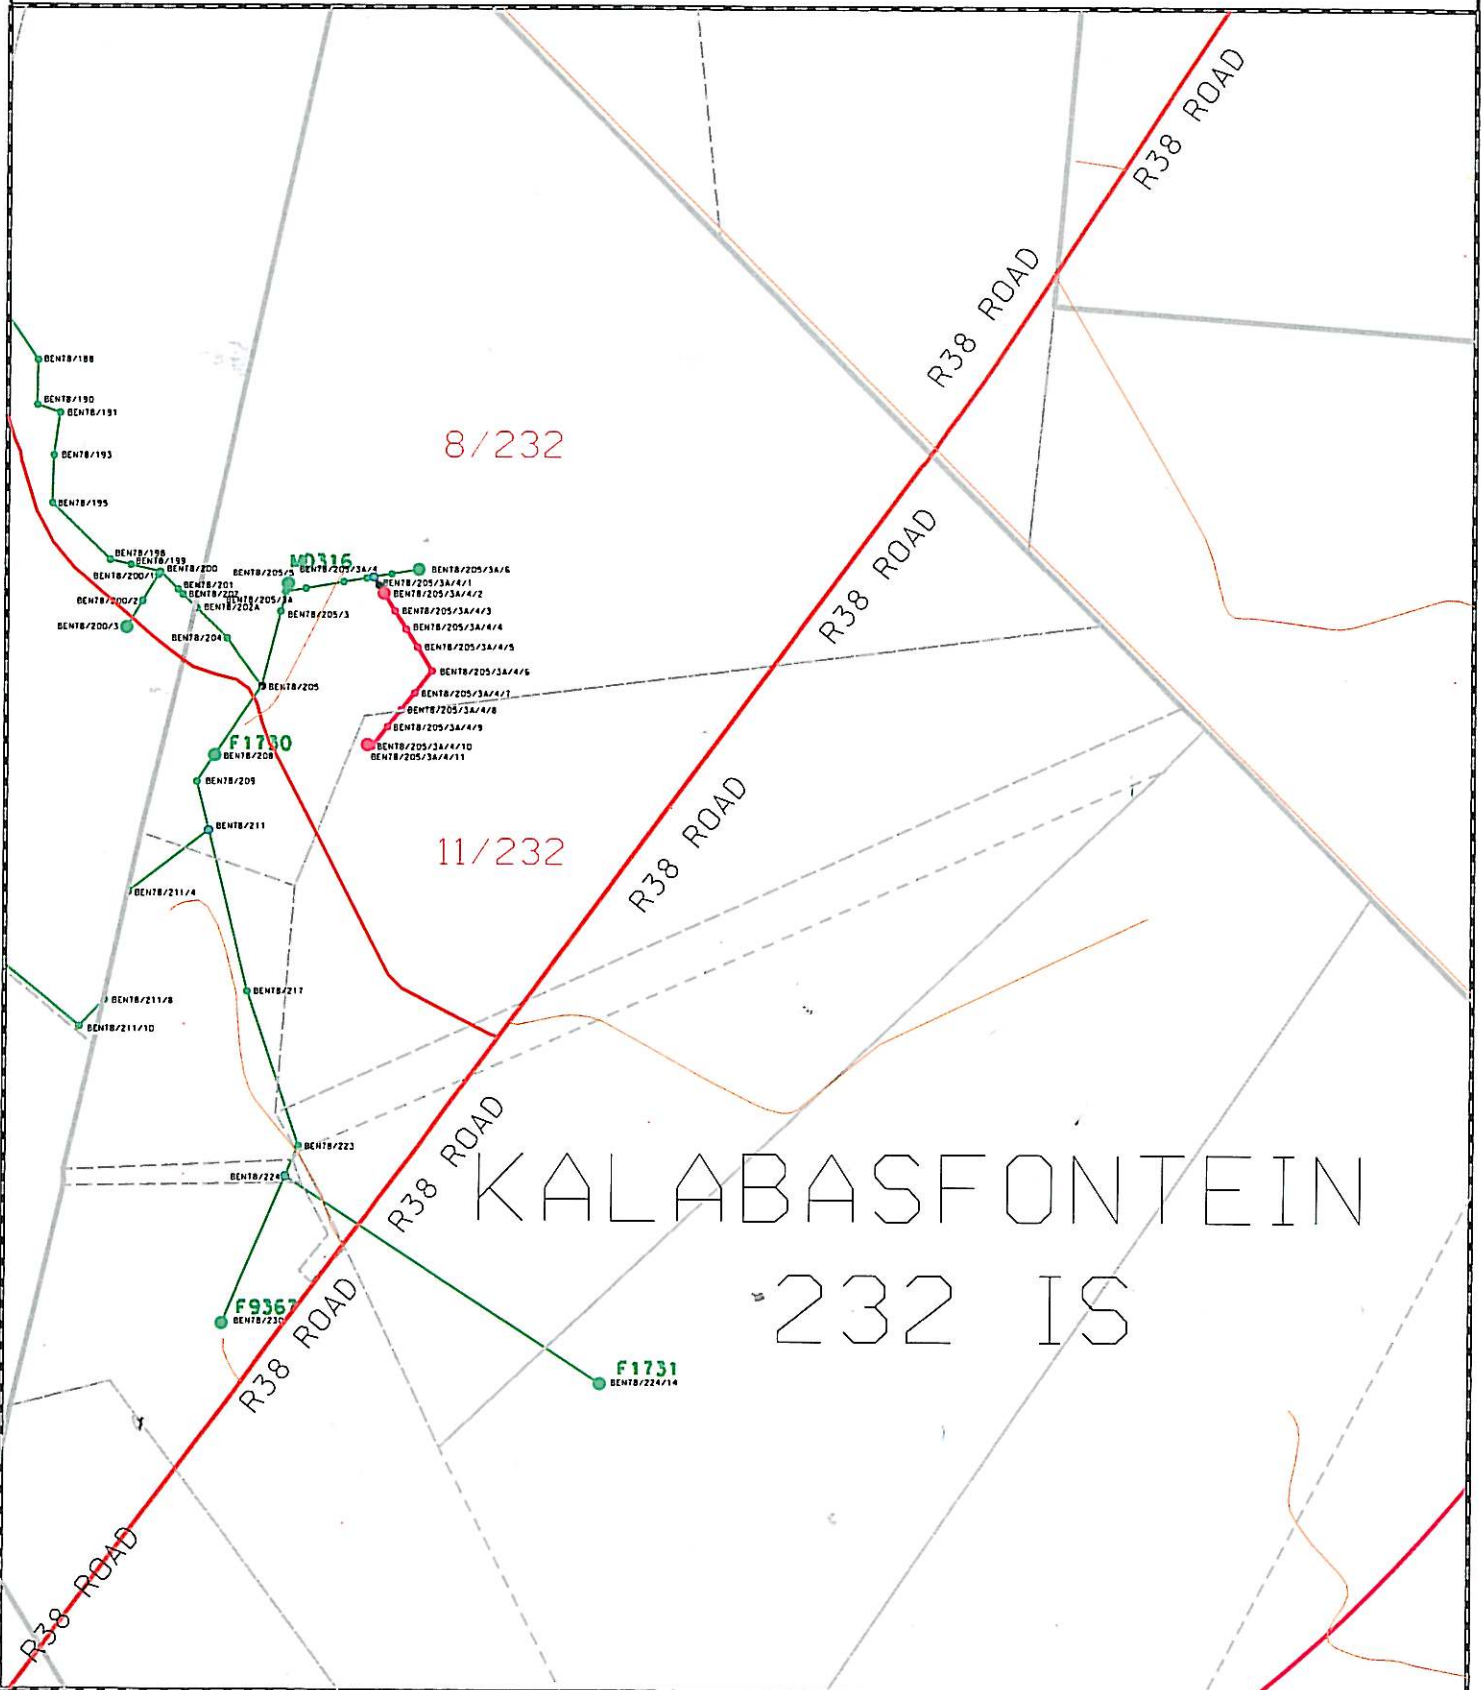


Route plan
Mpumalanga Operating Unit

Disclaimer
Geographic Mapping Wtbank are not responsible for any errors in external datasets displayed on this map. The following external datasets were used: Cadastral and Topographical



Feeder: BETHAL-BETHAL NORTH 11KV
Customer: KALABASFONTEIN VILLAGE
Project No: SURVEY OF AS BUILT LINES
FSA / TSA Area:

Portion of map no:

Scale: 1:25 000

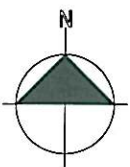

WGS84

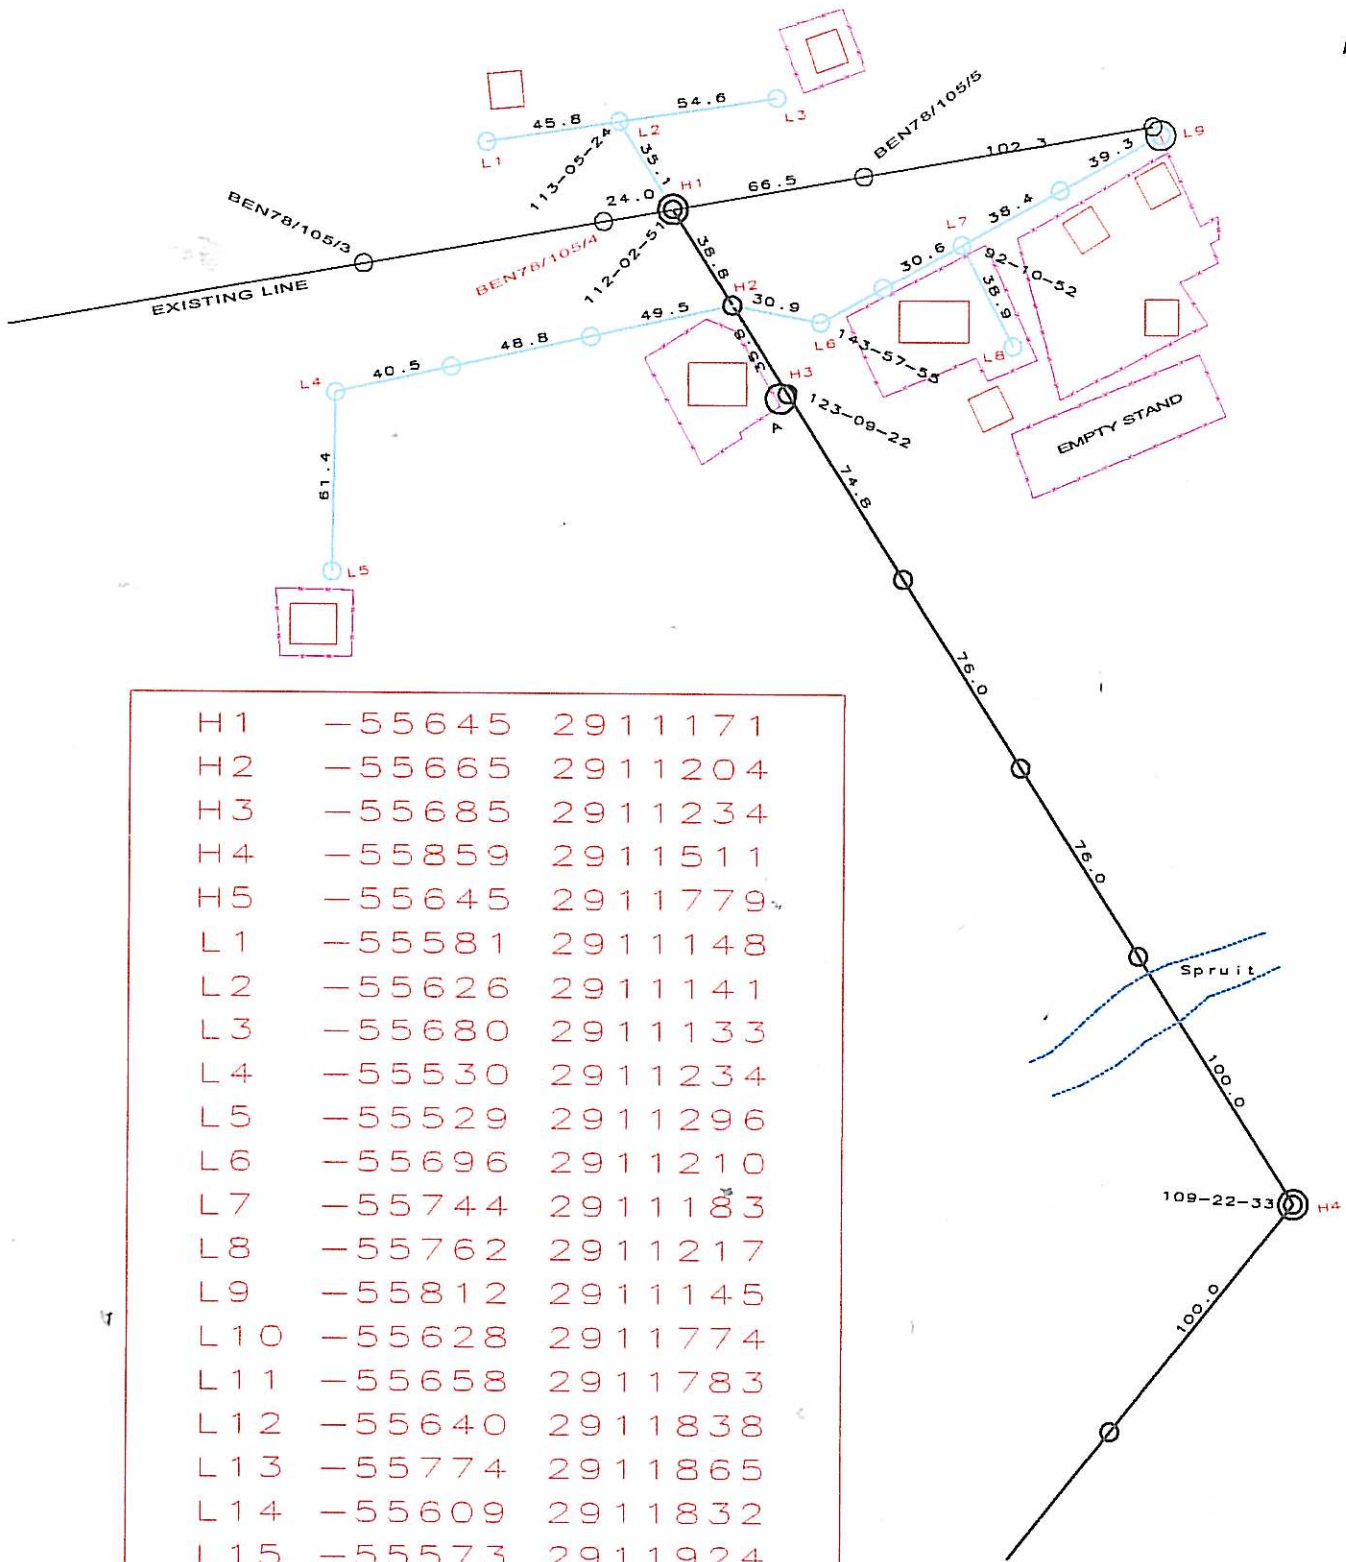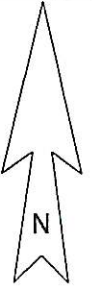

H1	-55645	2911171
H2	-55665	2911204
H3	-55685	2911234
H4	-55859	2911511
H5	-55645	2911779
L1	-55581	2911148
L2	-55626	2911141
L3	-55680	2911133
L4	-55530	2911234
L5	-55529	2911296
L6	-55696	2911210
L7	-55744	2911183
L8	-55762	2911217
L9	-55812	2911145
L10	-55628	2911774
L11	-55658	2911783
L12	-55640	2911838
L13	-55774	2911865
L14	-55609	2911832
L15	-55573	2911924
L16	-55649	2911945
L17	-55525	2911989

KALABASFONTEIN VILLAGE

Survey of As_Build Lines and New line A B

Surveyed by: M J van Loggerenberg 0824450039

Date: 06-10-2014

As_Build Lines 1128.36m

Survey of New Line = 669.96

