


AS BUILT INCORPORATIONS


Mr. F. J. S. G. 70-10-92

APPROVED PLAN
 No. 017/1/40 APP. 30 Jun 1991
 No. 0596/0786 APP. 24/1/86
 No. 1121/3/84 APP. 10/1/85


2/2 COPY 3
CITY OF DURBAN
 PLAN NUMBER
 0763/86/92/3

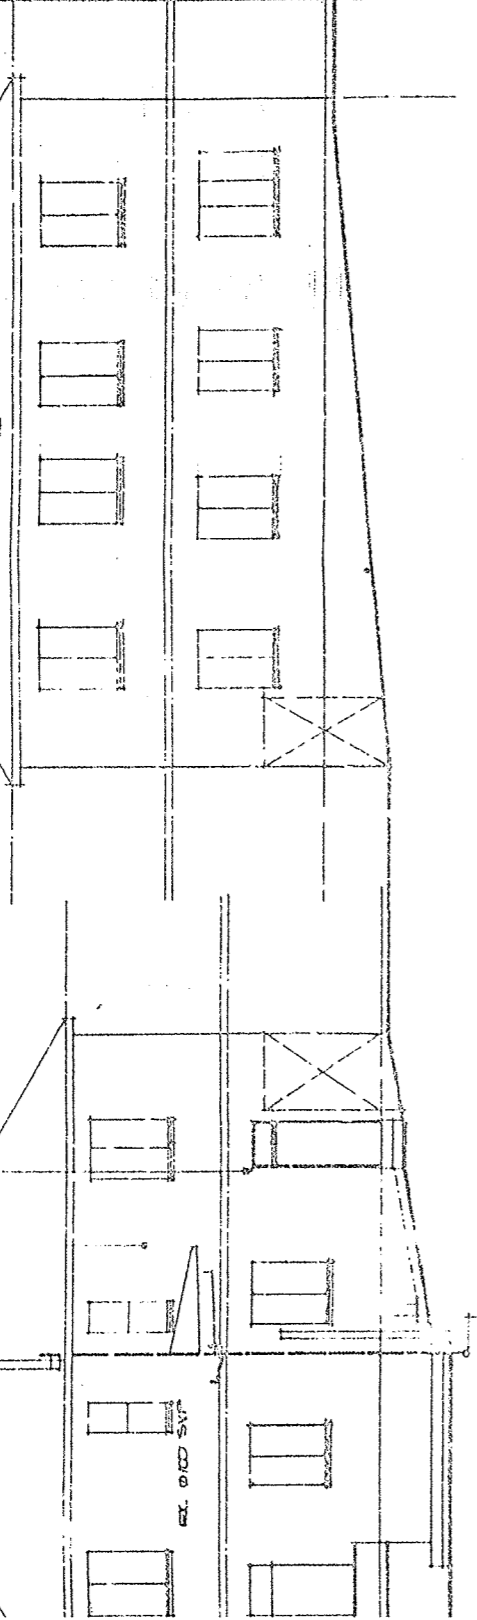

east elevation

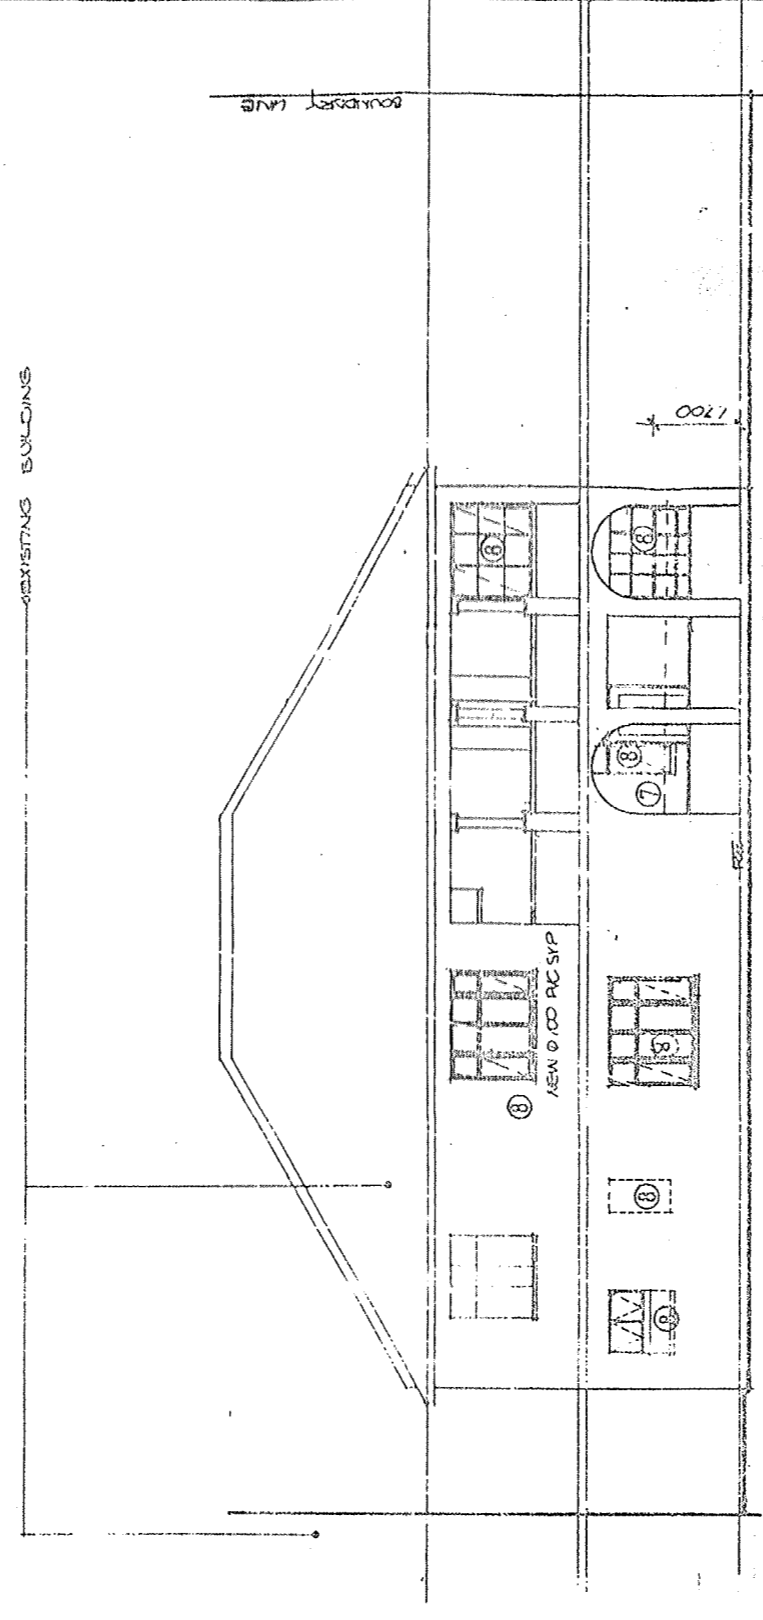

north elevation

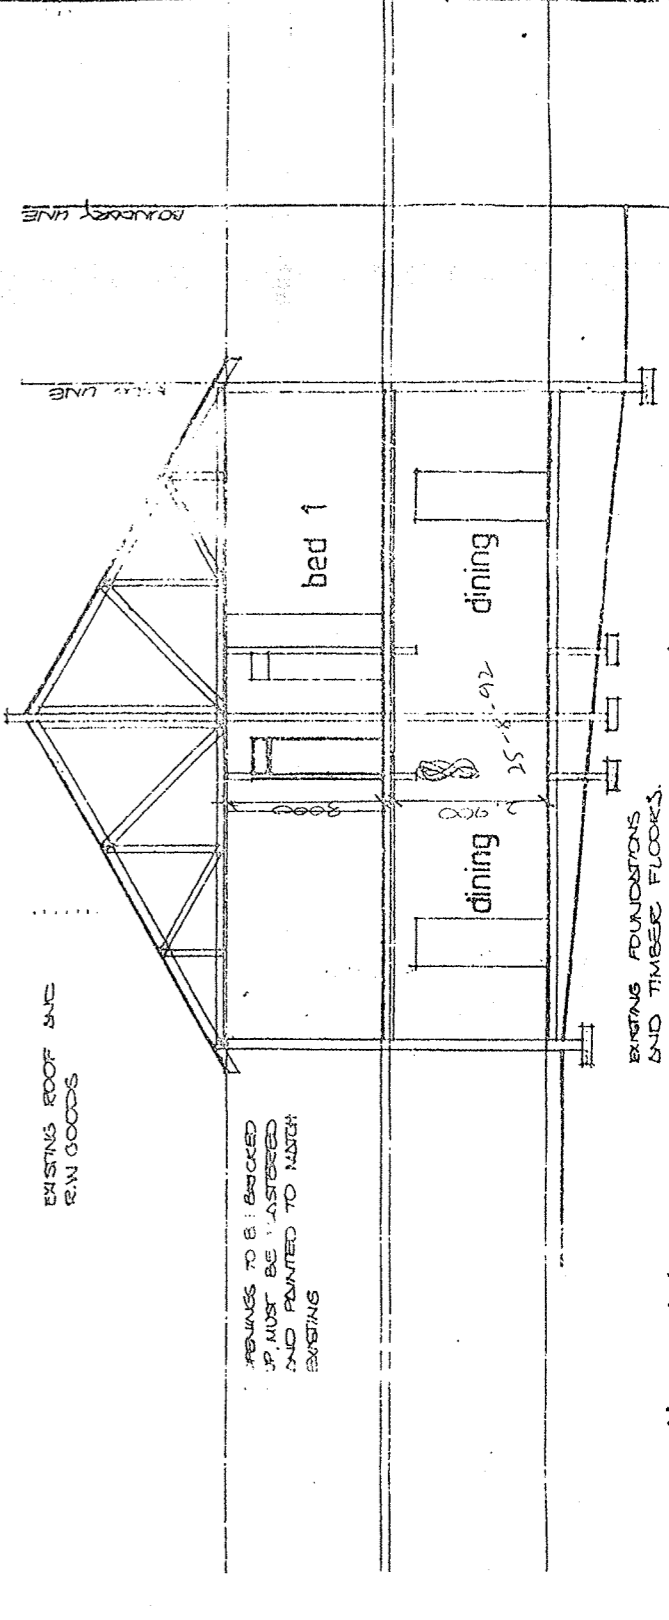

section AA

APPROVED: R. A. MOORE
 EXECUTIVE DIRECTOR, PHYSICAL
 ENVIRONMENT SERVICE UNIT
 - 1 SEP 1988 MR. *R. Moore*
 DATE

ELECTRICITY SEE
 Any person undertaking building work in circumstances in which the plan is required to be approved by the Durban City Council shall be responsible for:
 1) The provision of electricity services and wiring in accordance with the Electricity Regulations.
 2) The provision of electricity services and wiring in accordance with the Electricity Regulations, Substations, Water mains and Cable ducts.

DEVELOPMENT CONTROL DEPT.
 TOWN PLANNING AUTHORITY
GRANTED
 1992-08-27
 Signature: *[Signature]*
 Checked: *[Signature]*

DATE ISSUED
 24.06.1992
 Mr. *[Signature]* for *[Signature]*

amendments to app. plan no.
 0017/12/90/5
 at 24 f 32 venice road, durban
 for

CHRISHLTON PROPERTIES (C.C.)
CHRISHLTON

design
 for modern
 living

dwg. no.
 127-2b

scale 1/100 date July 90 *[Signature]*