

NOTES:



THIS DRAWING IS PROTECTED UNDER THE COPYRIGHT ACT OF 1963 AND CANNOT BE LOANED OR REPRODUCED IN PART OR IN WHOLE WITHOUT THE AUTHOR'S CONSENT.
 1. CHECK ALL DIMENSIONS ON SITE PRIOR TO COMMENCING CONSTRUCTION. READ ONLY FIGURED DIMENSIONS AND DO NOT SCALE. ANY DISCREPANCIES TO BE REPORTED TO THE ARCHITECT PRIOR TO COMMENCING WORK.

FLOORS:
 All ground floor slabs to be to engineers detail on USB green plastic underlaid on well prepared earth.

GLAZING:
 All glazing to comply with PART N of the NBR and PART N12 and N13 of SABS 6400

DRAINAGE:
 Schedule to link into existing SVP which is linked to municipal sewer.
 Stormwater to run into existing gutters or into to existing gutters.
 Slop to be 1 in 100 for every 400mm of roofed and paved area.

BALUSTRADES, HANDRAILS, HEIGHTS, OPENINGS:
 To comply with N13 and DD2.4 of SABS 6400

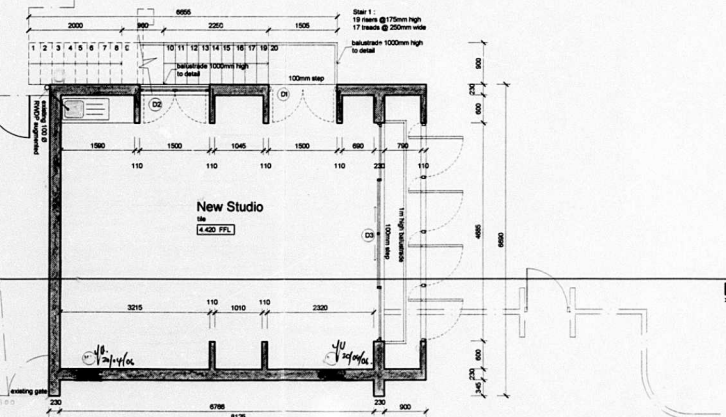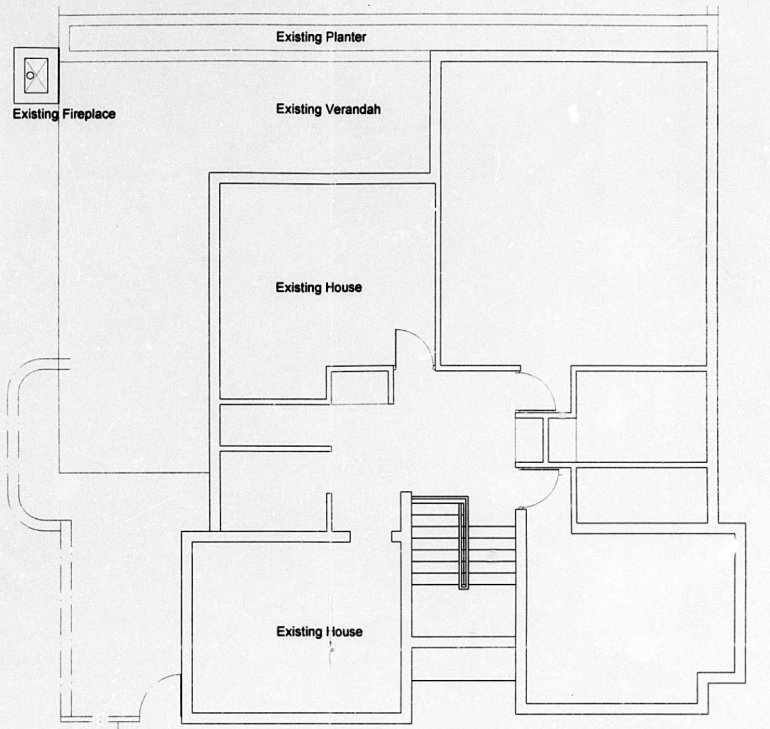

FIRST FLOOR PLAN
 scale 1:50

AS BUILT

Handwritten signature and date: 12/06/08

SHEET 2/3 COPY 3
 ETHIOPIAN MUNICIPALITY
 Plan No. T 524 B 5 05
 APPROVED in terms of the National Building Regulations and Building Standards Act Number 105 of 1977.
 APPROVED BY: *Handwritten signature*
 Title: *Handwritten signature*
 This Plan is a copy of the original. The information herein is not to be used for any other purpose without the written consent of the Architect.

SITE INSPECTION IN ORDER
 D.B.I. *Handwritten signature*
 S.B.I. *Handwritten signature*
 DATE: 12/06/08



SHOULD WORK NOT HAVE COMMENCED THIS APPROVAL WILL EXPIRE ON ITS FIRST ANNIVERSARY DATE.



Handwritten signature
 Engineer's signature: *Handwritten signature* Ref No: 031 2094865 Job Number:
Handwritten signature
 Surveyor's signature: *Handwritten signature* Ref No: 031 2094865 Valued Valued

Joy brasier architect
 6 Harold Avenue, Durban, 4001 Tel: 031 209 4865 Fax: 031 209 4862

PROJECT	PROPOSED ADDITIONS AND ALTERATIONS TO No. 6 NONOTI AVENUE, MUSGRAVE, DURBAN, RATE No. 282/05910034	REF: 12 OF 2148 DURBAN
DRAWING	FIRST FLOOR PLAN	

NAME	ADDRESS	PHONE	STATUS	DATE	TIME
R. K. N. N. N.	4 NONOTI	2077 237	<i>Handwritten signature</i>	01/05	1:20
<i>Handwritten signature</i>	409 CURIE RD	2044 888	<i>Handwritten signature</i>	01	
<i>Handwritten signature</i>	68 DORIS STREET (off) 5 NONOTI AVENUE	2021 543	<i>Handwritten signature</i>		
<i>Handwritten signature</i>	11, Chelmsford Street, Durban	2080 071	<i>Handwritten signature</i>		
<i>Handwritten signature</i>	58 RIVERVIEW CHURCH AIR MUSGRAVE RD	303 3644	<i>Handwritten signature</i>		