

1 Roof Plan
1:50

KEY REFERENCES	
Key Value	Description

- GENERAL DRAWING NOTES**
- THE DESIGN ON THIS DRAWING IS COPYRIGHT AND REMAINS THE PROPERTY OF THE ARCHITECTS.
 - ALL WORK TO BE CARRIED OUT STRICTLY IN ACCORDANCE WITH MUNICIPAL REGULATIONS.
 - DRAWINGS NOT TO BE SCALED, ONLY ANNOTATED DIMENSIONS TO BE USED.
 - ALL RELEVANT DATUM, LEVELS, DIMENSIONS TO BE CHECKED ON SITE BEFORE COMMENCEMENT OF WORK.
 - ALL DRAWINGS ARE TO BE CHECKED BY THE MAIN CONTRACTOR AND ANY DISCREPANCIES ON THE DRAWINGS OR BETWEEN THE DRAWINGS ARE TO BE REFERRED TO THE ARCHITECT.
 - CONTRACTOR TO CHECK ALL QUANTITIES PRIOR TO ORDERING AND MANUFACTURE.
 - CONTRACTOR TO PROVIDE SHOP DRAWINGS FOR APPROVAL BY ARCHITECT PRIOR TO MANUFACTURE.

Revision:

No.:	Date:	Description:

Client: _____

Signature: _____ Date: _____



Professional Architects signature
Mr. K.P. Mawesina (Pr. Arch) sacap (7902) sala (7593)



Project Title:
KZN MUSEUM

Date: 2020/07/14 12:36:34 Scale: _____


Drawn: Author Drawing Description:
BLOCK G - AS BUILT ROOF PLAN

Job no.:	Drawing no.:	Rev. no.:
S511	G_P_102	

ISSUED FOR APPROVAL	
ISSUED FOR INFORMATION	
ISSUED FOR SUBMISSION	
ISSUED FOR TENDER	
ISSUED FOR CONSTRUCTION	

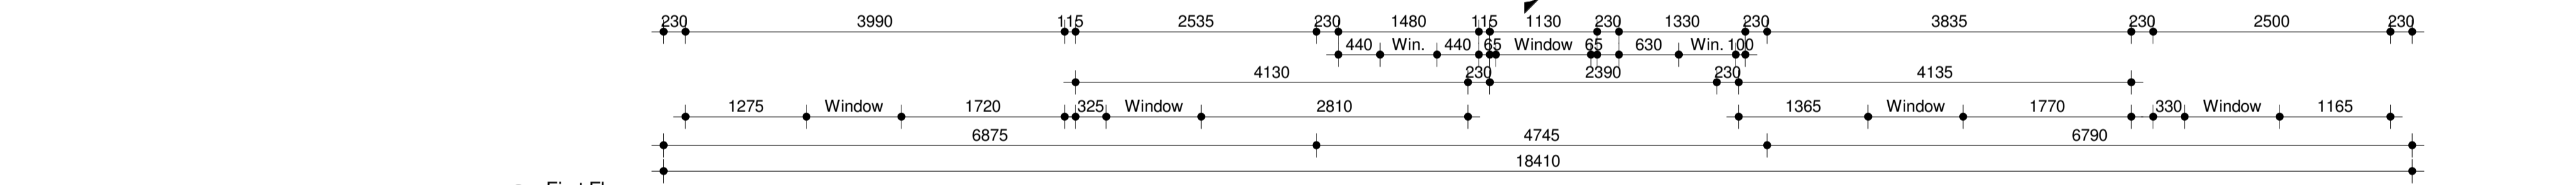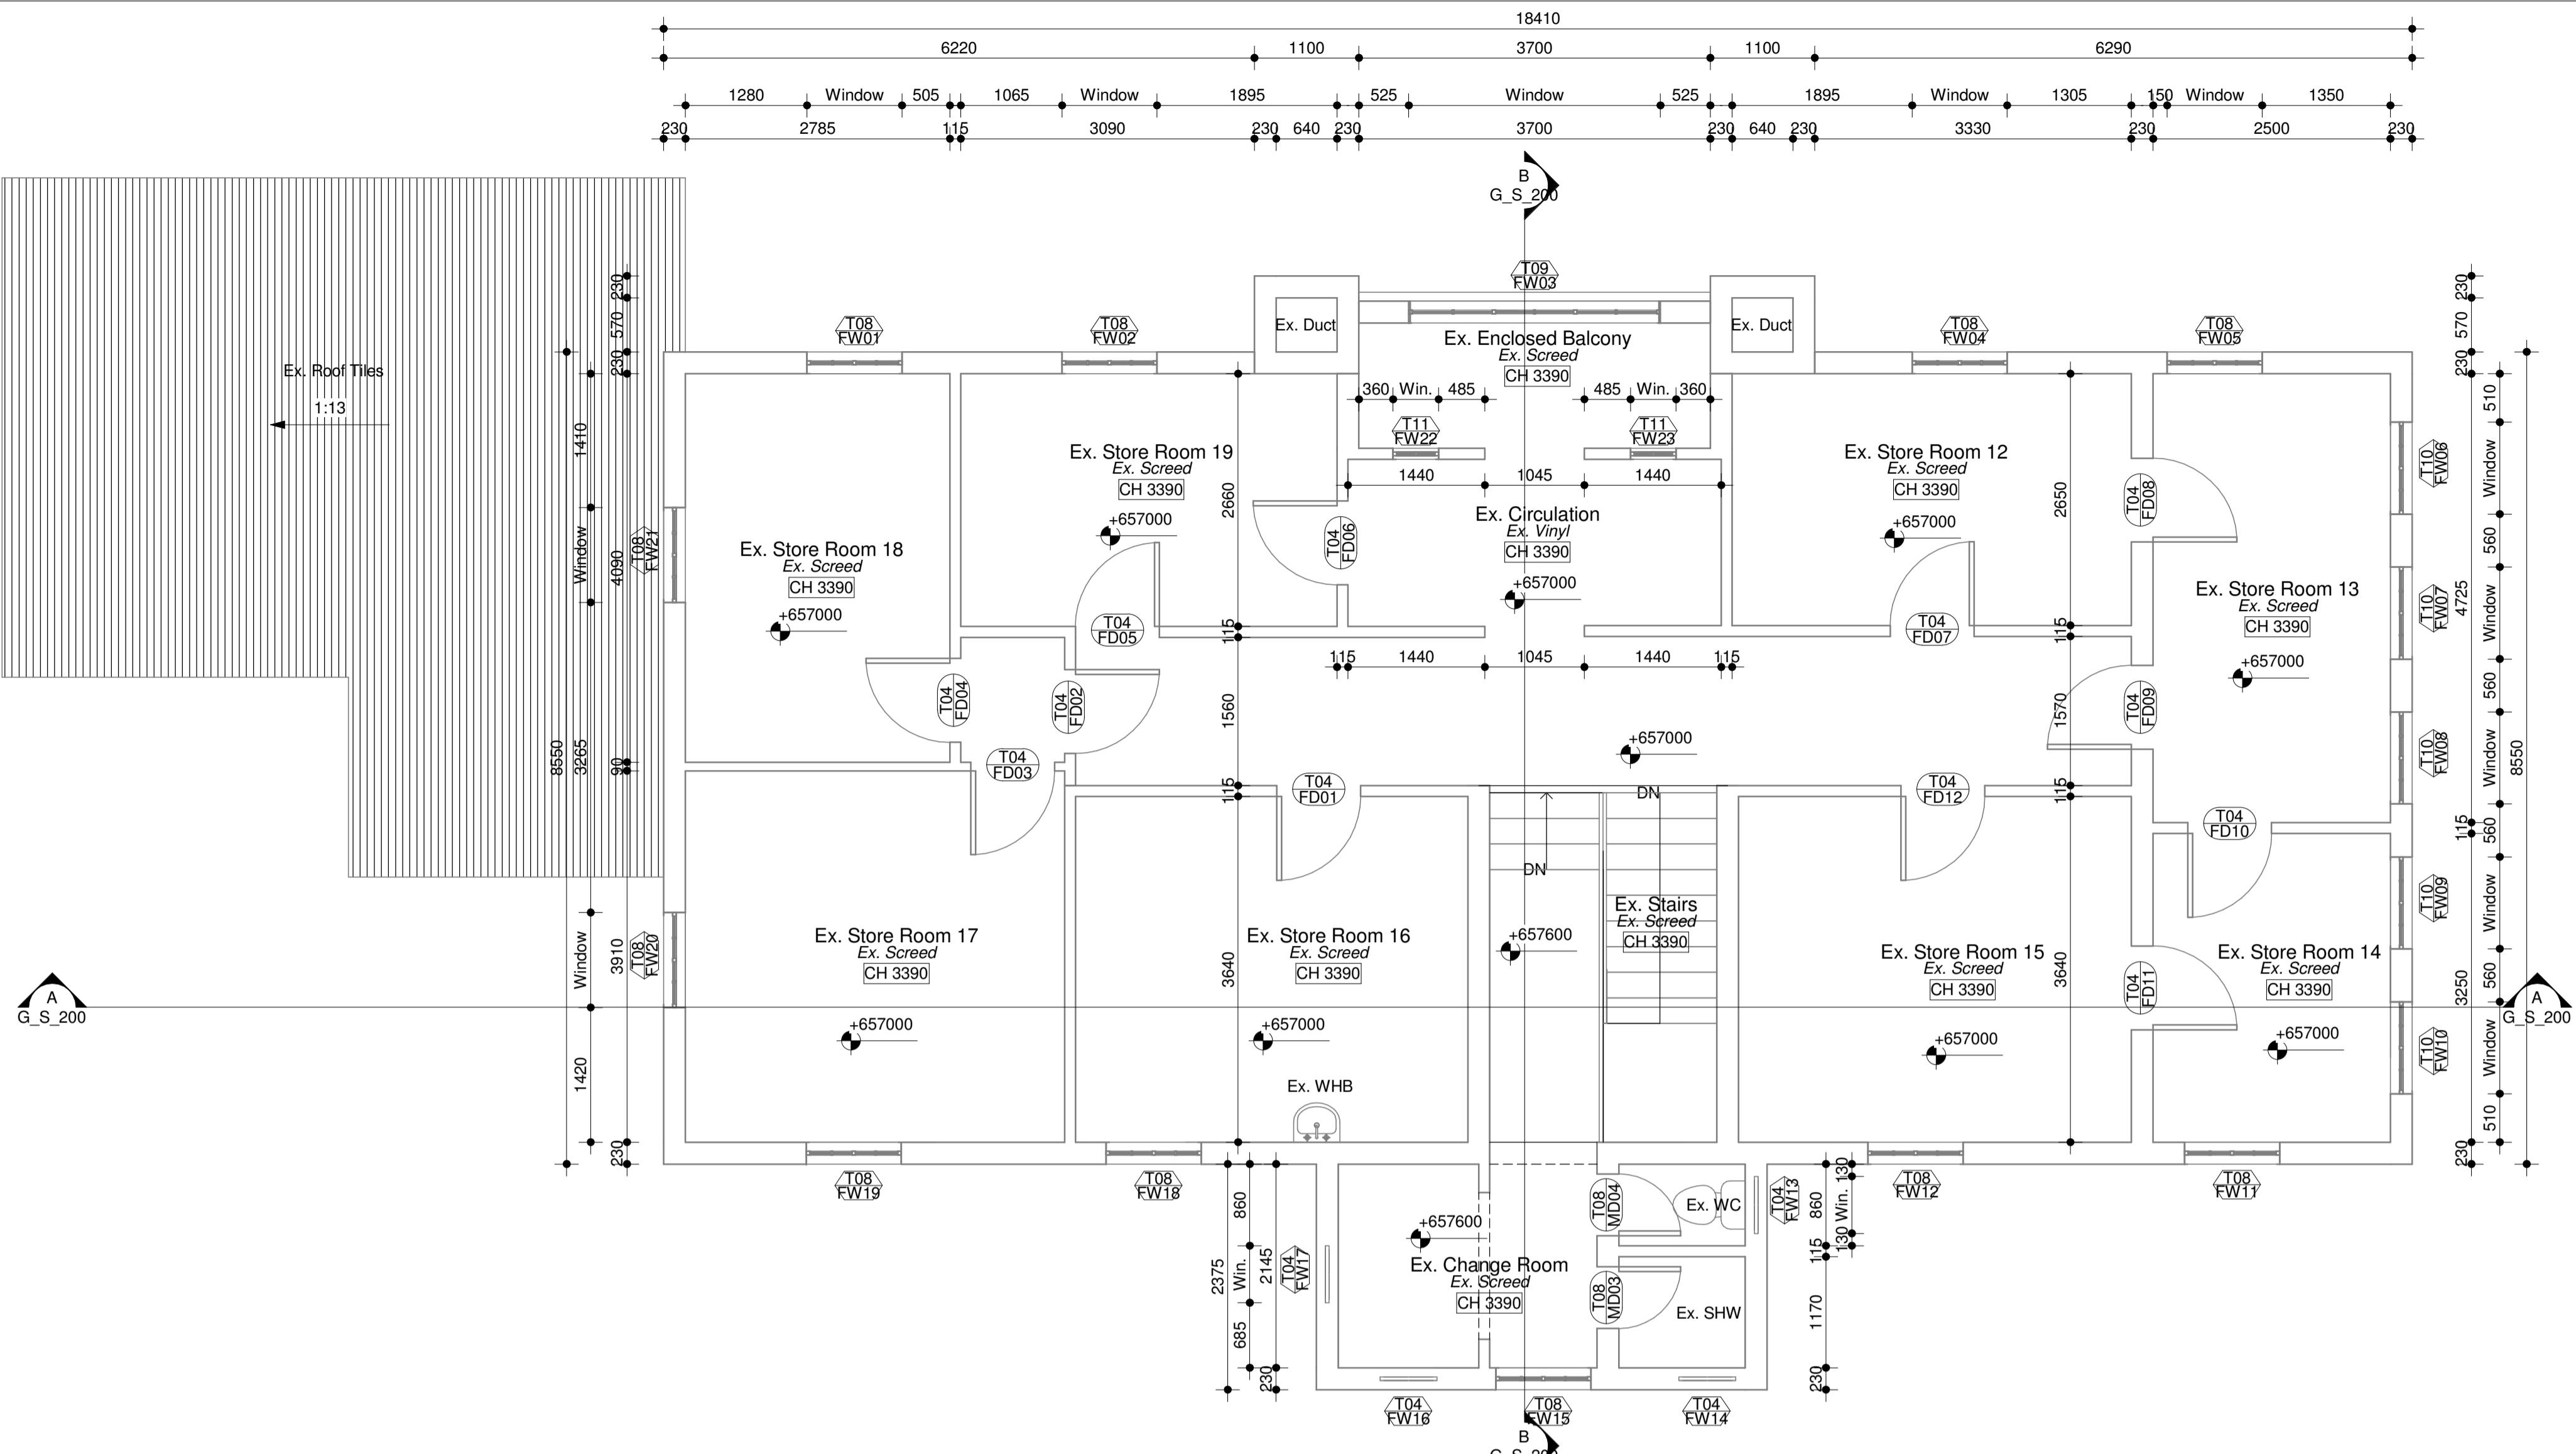

1 First Floor
1 : 50

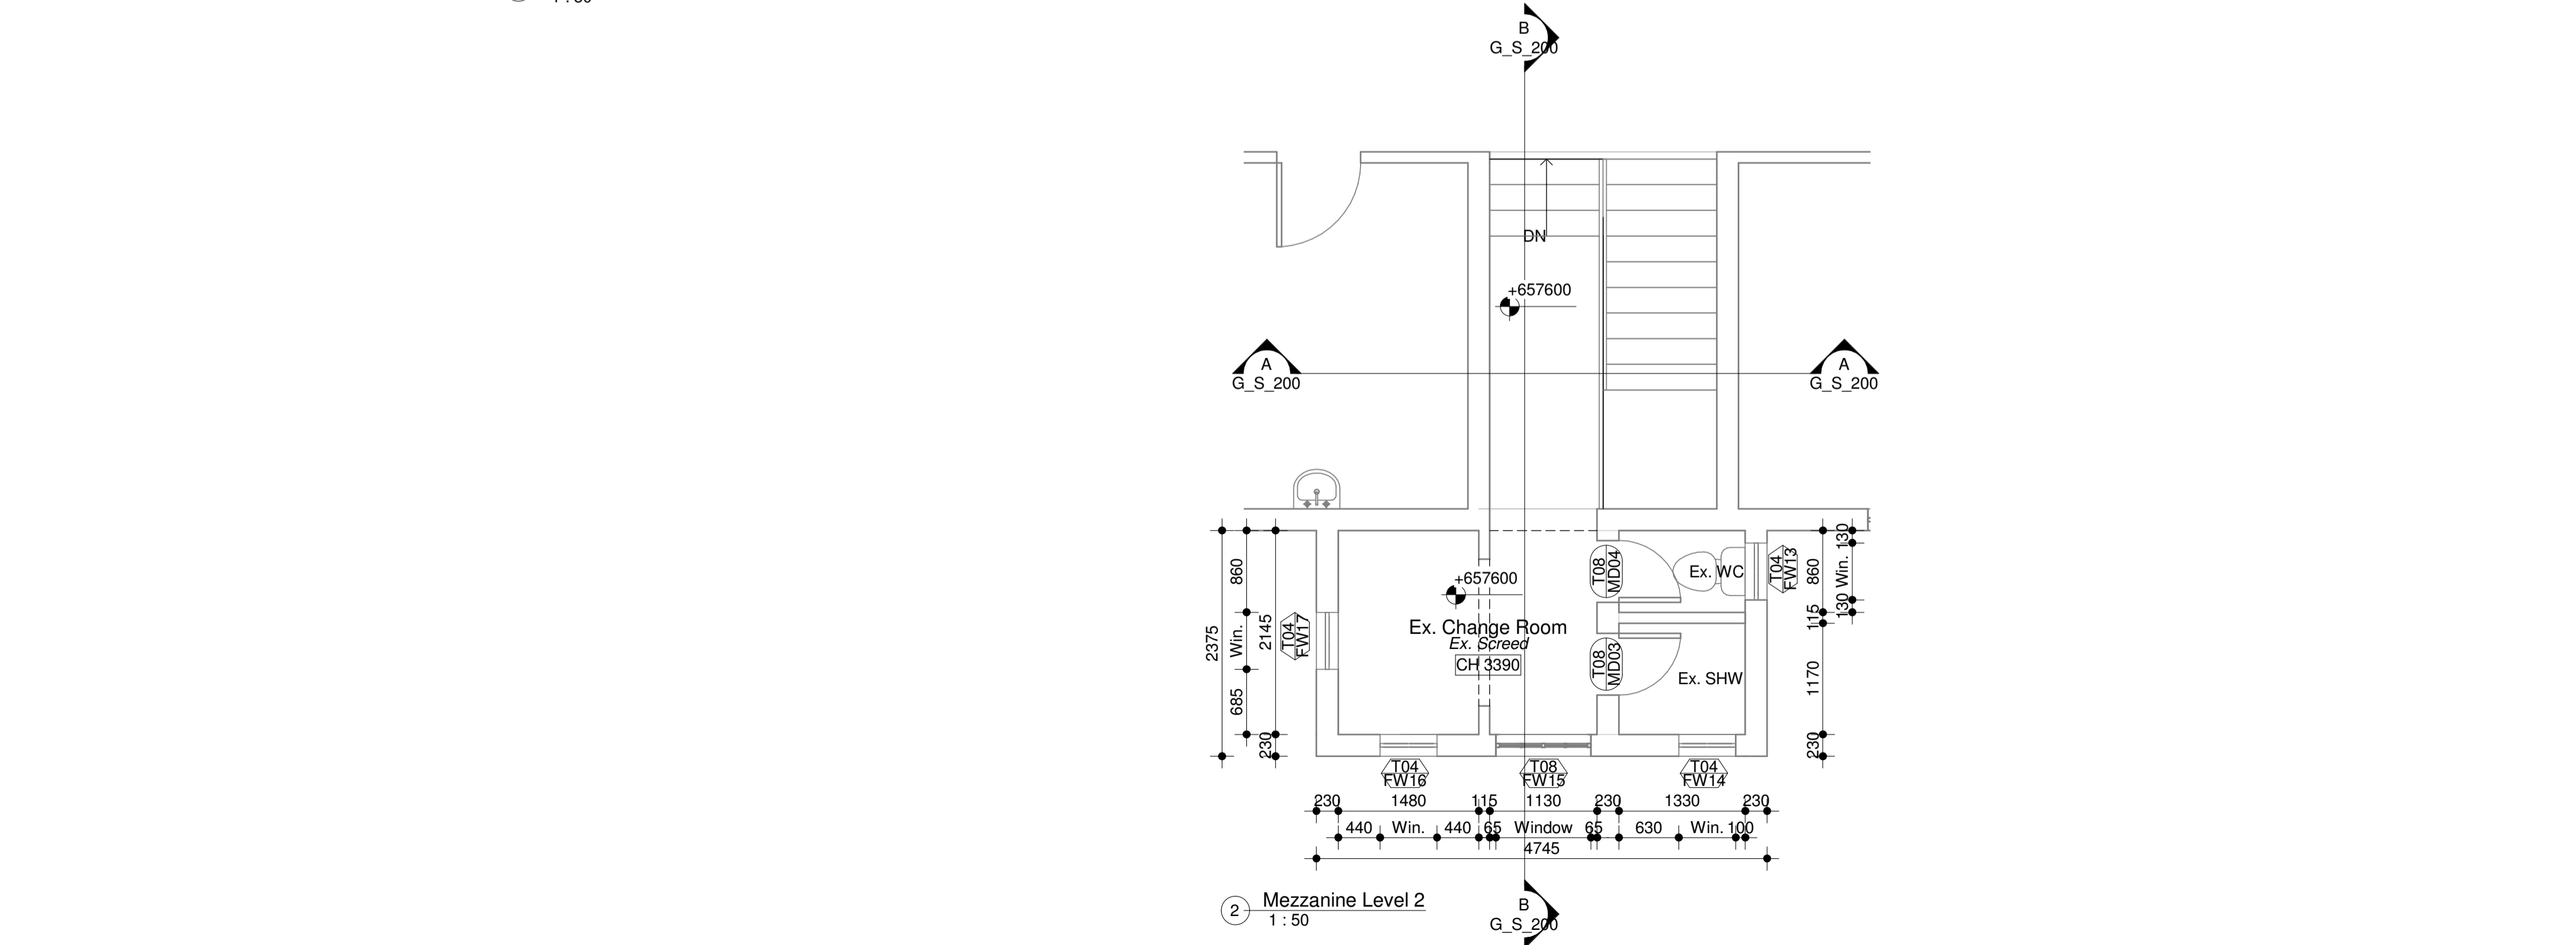

2 Mezzanine Level 2
1 : 50

KEY REFERENCES	
Key Value	Description

- GENERAL DRAWING NOTES**
- THE DESIGN ON THIS DRAWING IS COPYRIGHT AND REMAINS THE PROPERTY OF THE ARCHITECTS.
 - ALL WORK TO BE CARRIED OUT STRICTLY IN ACCORDANCE WITH MUNICIPAL REGULATIONS.
 - DRAWINGS NOT TO BE SCALED, ONLY ANNOTATED DIMENSIONS TO BE USED.
 - ALL RELEVANT DATUM, LEVELS, DIMENSIONS TO BE CHECKED ON SITE BEFORE COMMENCEMENT OF WORK.
 - ALL DRAWINGS ARE TO BE CHECKED BY THE MAIN CONTRACTOR AND ANY DISCREPANCIES ON THE DRAWINGS OR BETWEEN THE DRAWINGS ARE TO BE REFERRED TO THE ARCHITECT.
 - CONTRACTOR TO CHECK ALL QUANTITIES PRIOR TO ORDERING AND MANUFACTURE.
 - CONTRACTOR TO PROVIDE SHOP DRAWINGS FOR APPROVAL BY ARCHITECT PRIOR TO MANUFACTURE.

Revision:

No.:	Date:	Description:

Client

Signature: _____ Date: _____



Professional Architects signature
Mr K.P Mavesana (Pr. Arch) sacap (7902) sala (7593)

Project Title:
KZN MUSEUM

Date: 2020/07/14 12:36:34 Scale:

Drawn: CJ
Drawing Description:
BLOCK G - AS BUILT FIRST FLOOR AND MEZZANINE LEVEL 2 PLAN



Job no.:	Drawing no.:	Rev. no.:
S511	G_P_101	REV.00

ISSUED FOR APPROVAL	
ISSUED FOR INFORMATION	
ISSUED FOR SUBMISSION	
ISSUED FOR TENDER	
ISSUED FOR CONSTRUCTION	

KEY REFERENCES	
Key Value	Description

- GENERAL DRAWING NOTES**
- THE DESIGN ON THIS DRAWING IS COPYRIGHT AND REMAINS THE PROPERTY OF THE ARCHITECTS.
 - ALL WORK TO BE CARRIED OUT STRICTLY IN ACCORDANCE WITH MUNICIPAL REGULATIONS.
 - DRAWINGS NOT TO BE SCALED, ONLY ANNOTATED DIMENSIONS TO BE USED.
 - ALL RELEVANT DATUM, LEVELS, DIMENSIONS TO BE CHECKED ON SITE BEFORE COMMENCEMENT OF WORK.
 - ALL DRAWINGS ARE TO BE CHECKED BY THE MAIN CONTRACTOR AND ANY DISCREPANCIES ON THE DRAWINGS OR BETWEEN THE DRAWINGS ARE TO BE REFERRED TO THE ARCHITECT.
 - CONTRACTOR TO CHECK ALL QUANTITIES PRIOR TO ORDERING AND MANUFACTURE.
 - CONTRACTOR TO PROVIDE SHOP DRAWINGS FOR APPROVAL BY ARCHITECT PRIOR TO MANUFACTURE.

Revision:
No.: Date: Description:

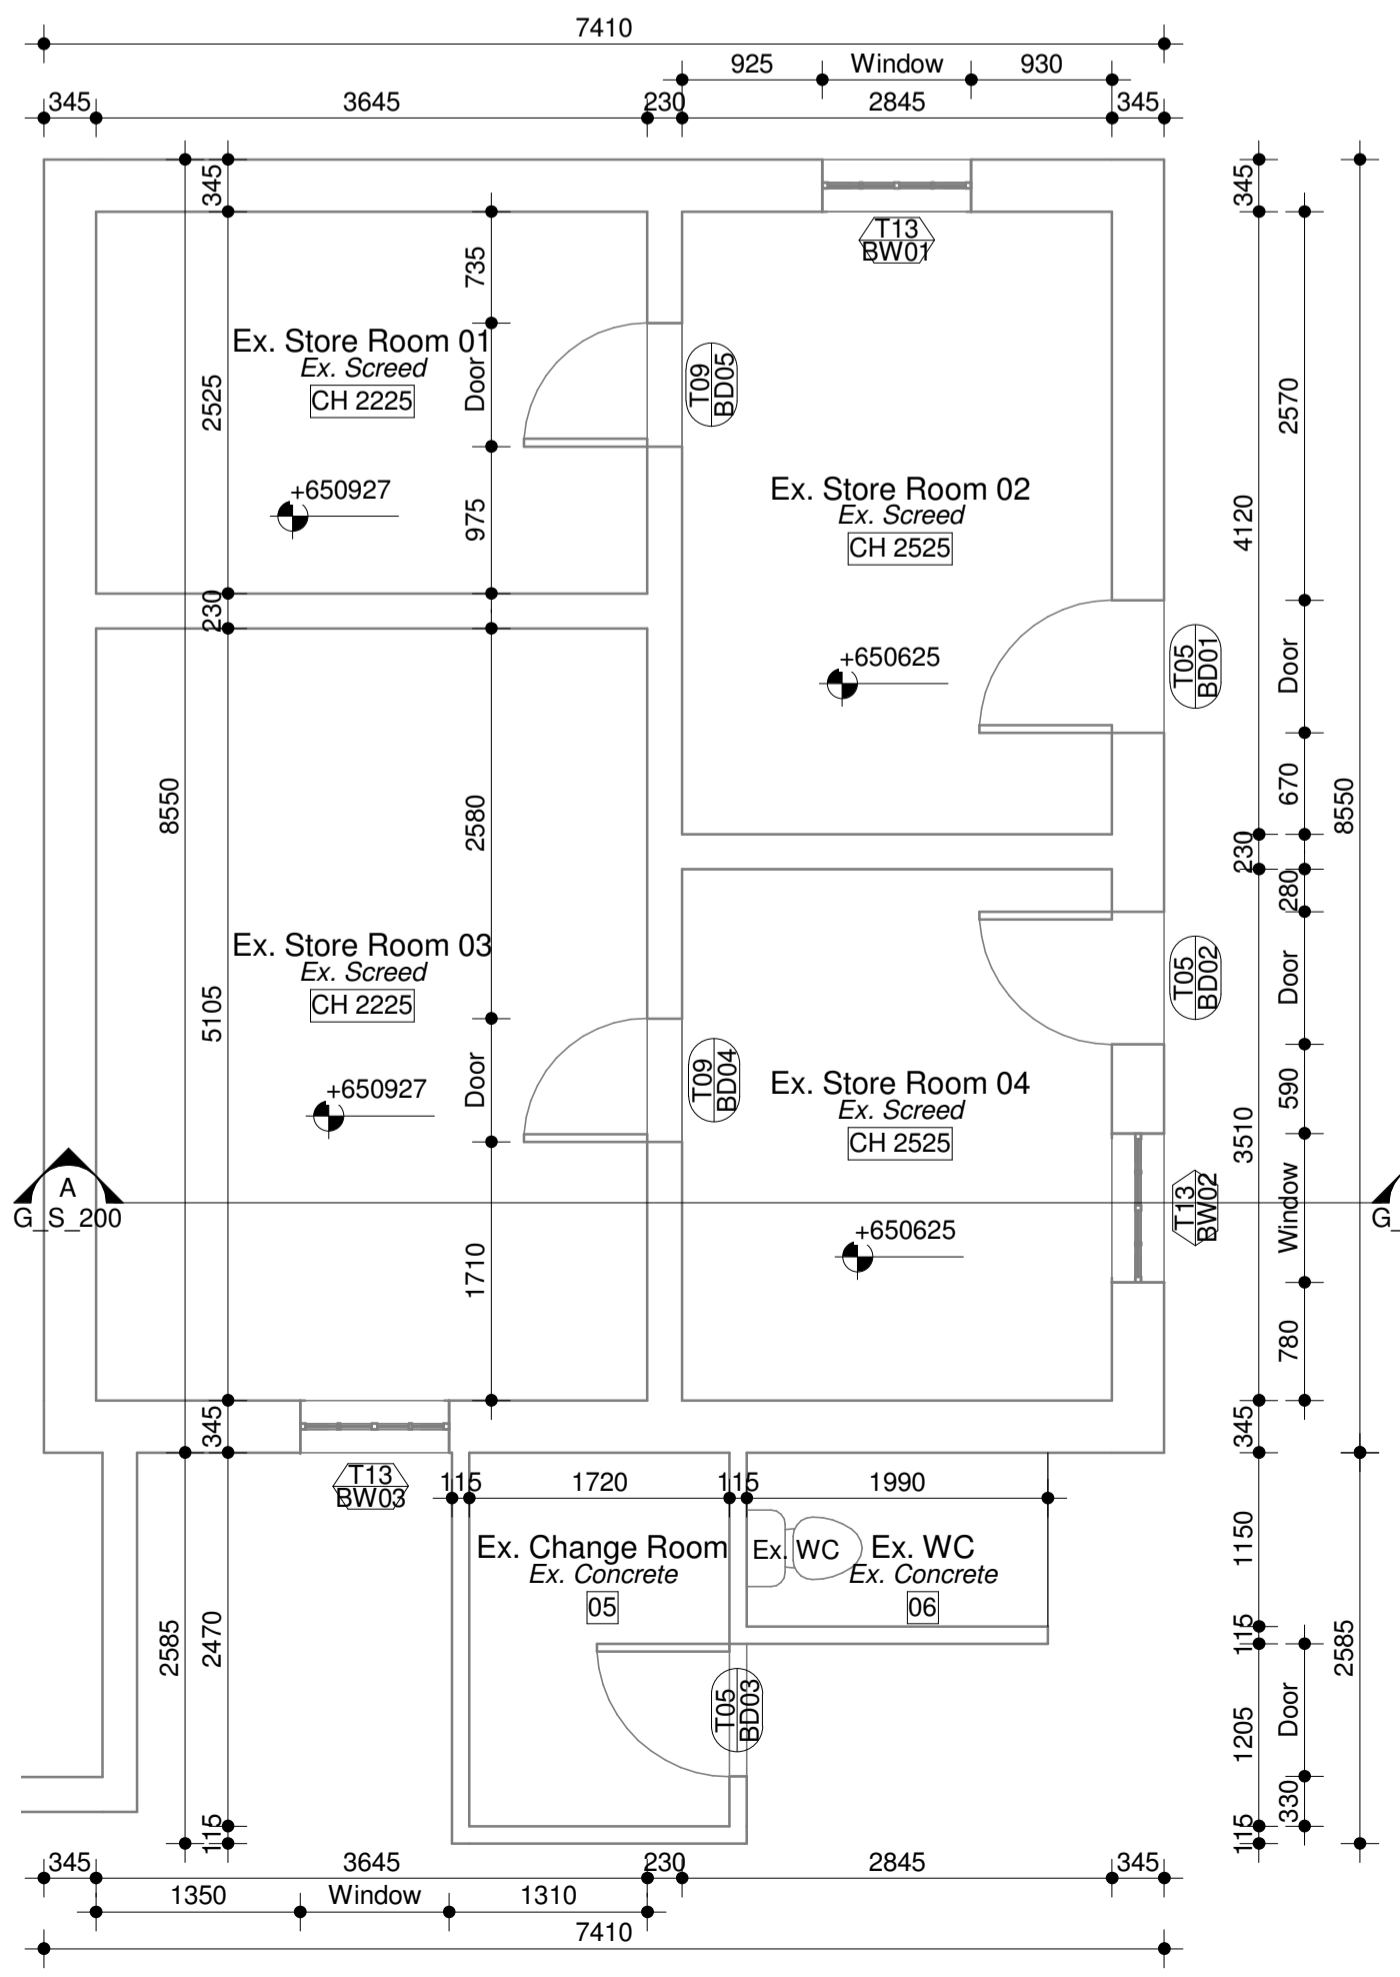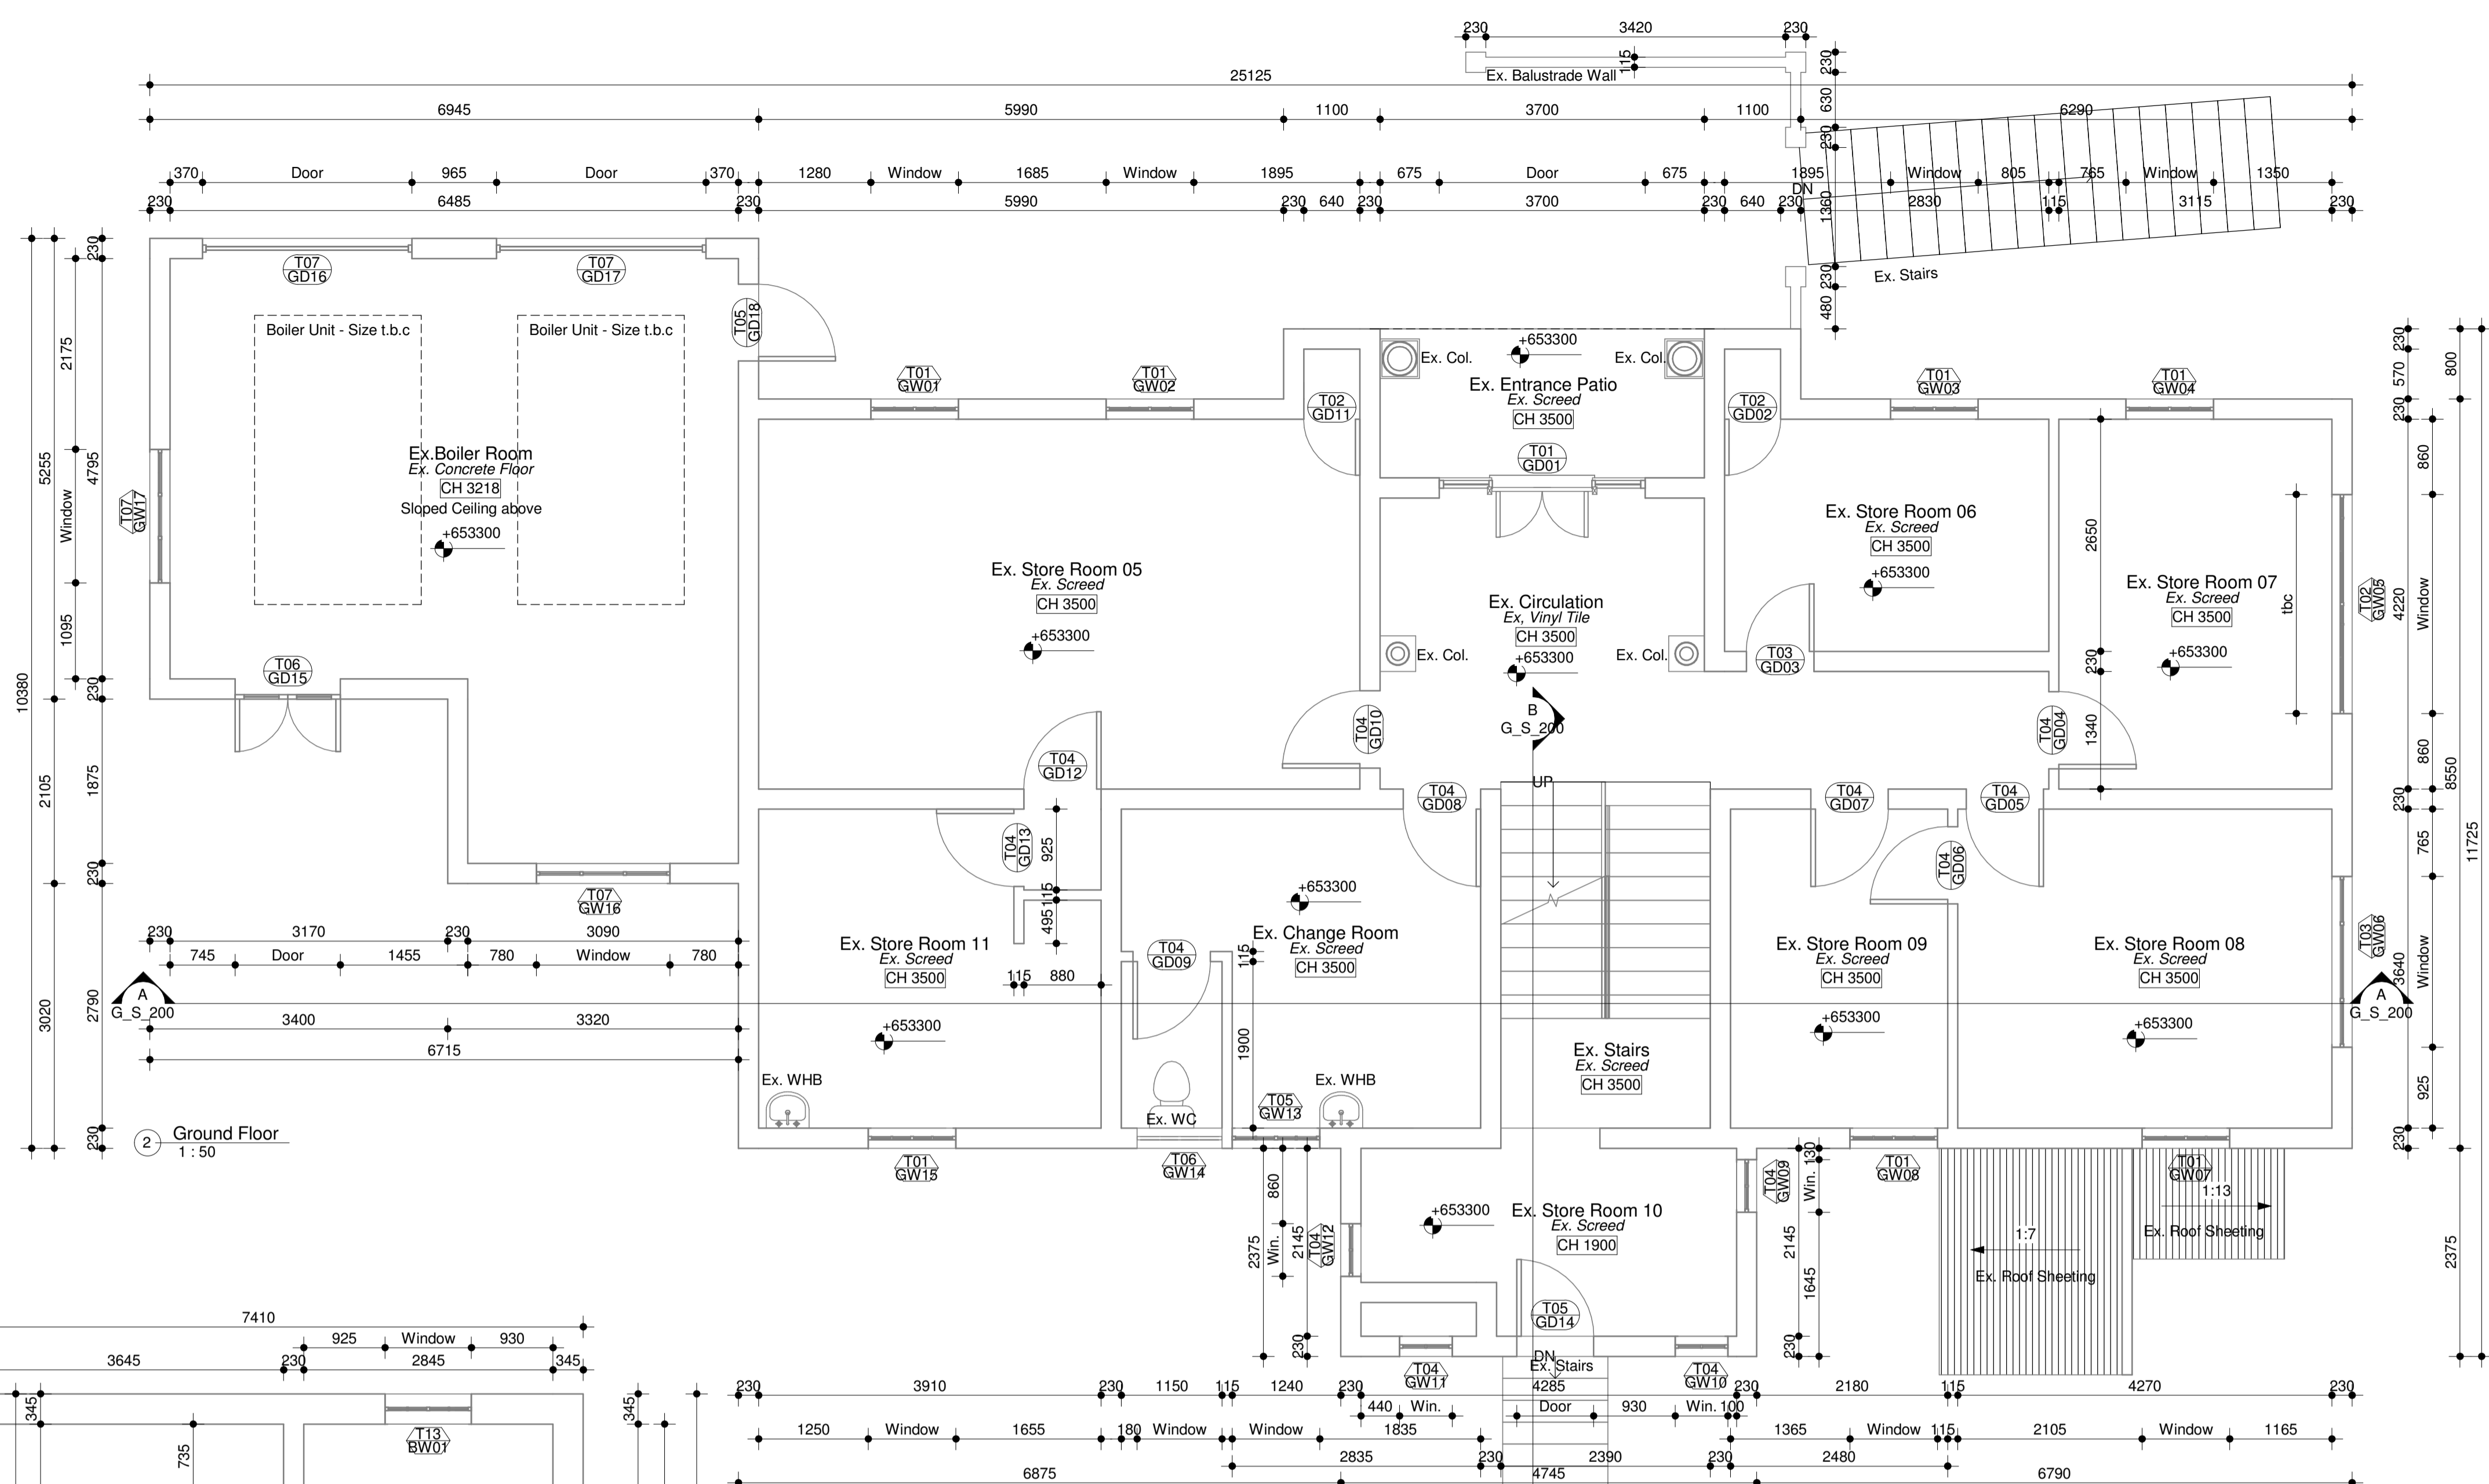

Area Schedule (Rentable) Bulk

Level	Name	Rm. No.	Area	Bulk
Basement Level	Ex. Store Room 01	18	9 m ²	Yes
Basement Level	Ex. Store Room 03	19	19 m ²	Yes
Basement Level	Ex. Store Room 02	20	12 m ²	Yes
Basement Level	Ex. Store Room 04	21	10 m ²	Yes
Basement Level	Ex. Change Room	22	4 m ²	Yes
Basement Level	Ex. WC	23	2 m ²	Yes
Ground Floor	Ex. Boiler Room	24	39 m ²	Yes
Ground Floor	Ex. Store Room 05	25	29 m ²	Yes
Ground Floor	Ex. Duct	26	0 m ²	Yes
Ground Floor	Ex. Duct	27	0 m ²	Yes
Ground Floor	Ex. Entrance Patio	28	6 m ²	Yes
Ground Floor	Ex. Circulation	29	18 m ²	Yes
Ground Floor	Ex. Store Room 06	30	10 m ²	Yes
Ground Floor	Ex. Store Room 07	31	13 m ²	Yes
Ground Floor	Ex. Store Room 08	32	16 m ²	Yes
Ground Floor	Ex. Store Room 09	33	9 m ²	Yes
Ground Floor	Ex. Change Room	34	15 m ²	Yes
Ground Floor	Ex. Store Room 11	35	14 m ²	Yes
Ground Floor	Ex. Store Room 10	36	9 m ²	Yes
Ground Floor	Ex. Stairs	37	9 m ²	Yes
Mezzanine Level	Ex. Change Room	38	9 m ²	Yes
First Floor	Ex. Store Room 18	39	11 m ²	Yes
First Floor	Ex. Store Room 19	40	11 m ²	Yes
First Floor	Ex. Enclosed Balcony	41	5 m ²	Yes
First Floor	Ex. Circulation	42	26 m ²	Yes
First Floor	Ex. Store Room 12	43	11 m ²	Yes
First Floor	Ex. Store Room 13	44	12 m ²	Yes
First Floor	Ex. Store Room 14	45	8 m ²	Yes
First Floor	Ex. Store Room 15	46	15 m ²	Yes
First Floor	Ex. Stair	48	4 m ²	Yes
First Floor	Ex. Store Room 16	49	15 m ²	Yes
First Floor	Ex. Store Room 17	50	16 m ²	Yes
Mezzanine Level 2	Ex. Change Room	51	9 m ²	Yes
Wall Plate	Ex. Roof	52	251 m ²	Yes
Grand total			651 m ²	

Area Schedule (Rentable)


Level	Name	Rm. No.	FAR	Cov.	Bulk
Basement Level	Ex. Store Room 01	18	Yes	No	Yes
Basement Level	Ex. Store Room 03	19	Yes	No	Yes
Basement Level	Ex. Store Room 02	20	Yes	No	Yes
Basement Level	Ex. Store Room 04	21	Yes	No	Yes
Basement Level	Ex. Change Room	22	Yes	No	Yes
Basement Level	Ex. WC	23	Yes	No	Yes
Ground Floor	Ex. Boiler Room	24	No	No	Yes
Ground Floor	Ex. Store Room 05	25	Yes	No	Yes
Ground Floor	Ex. Duct	26	No	No	Yes
Ground Floor	Ex. Duct	27	No	No	Yes
Ground Floor	Ex. Entrance Patio	28	Yes	No	Yes
Ground Floor	Ex. Circulation	29	Yes	No	Yes
Ground Floor	Ex. Store Room 06	30	Yes	No	Yes
Ground Floor	Ex. Store Room 07	31	Yes	No	Yes
Ground Floor	Ex. Store Room 08	32	Yes	No	Yes
Ground Floor	Ex. Store Room 09	33	Yes	No	Yes
Ground Floor	Ex. Change Room	34	Yes	No	Yes
Ground Floor	Ex. Store Room 11	35	Yes	No	Yes
Ground Floor	Ex. Store Room 10	36	Yes	No	Yes
Ground Floor	Ex. Stairs	37	Yes	No	Yes
Mezzanine Level	Ex. Change Room	38	Yes	No	Yes
First Floor	Ex. Store Room 18	39	Yes	No	Yes
First Floor	Ex. Store Room 19	40	Yes	No	Yes
First Floor	Ex. Enclosed Balcony	41	Yes	No	Yes
First Floor	Ex. Circulation	42	Yes	No	Yes
First Floor	Ex. Store Room 12	43	Yes	No	Yes
First Floor	Ex. Store Room 13	44	Yes	No	Yes
First Floor	Ex. Store Room 14	45	Yes	No	Yes
First Floor	Ex. Store Room 15	46	Yes	No	Yes
First Floor	Ex. Stair	48	Yes	No	Yes
First Floor	Ex. Store Room 16	49	Yes	No	Yes
First Floor	Ex. Store Room 17	50	Yes	No	Yes
Mezzanine Level 2	Ex. Change Room	51	Yes	No	Yes
Wall Plate	Ex. Roof	52	No	Yes	Yes

Area Schedule (Rentable) FAR

Level	Name	Rm. No.	Area	FAR
Basement Level	Ex. Store Room 01	18	9 m ²	Yes
Basement Level	Ex. Store Room 03	19	19 m ²	Yes
Basement Level	Ex. Store Room 02	20	12 m ²	Yes
Basement Level	Ex. Store Room 04	21	10 m ²	Yes
Basement Level	Ex. Change Room	22	4 m ²	Yes
Basement Level	Ex. WC	23	2 m ²	Yes
Ground Floor	Ex. Store Room 05	25	29 m ²	Yes
Ground Floor	Ex. Entrance Patio	28	6 m ²	Yes
Ground Floor	Ex. Circulation	29	18 m ²	Yes
Ground Floor	Ex. Store Room 06	30	10 m ²	Yes
Ground Floor	Ex. Store Room 07	31	13 m ²	Yes
Ground Floor	Ex. Store Room 08	32	16 m ²	Yes
Ground Floor	Ex. Store Room 09	33	9 m ²	Yes
Ground Floor	Ex. Change Room	34	15 m ²	Yes
Ground Floor	Ex. Store Room 11	35	14 m ²	Yes
Ground Floor	Ex. Store Room 10	36	9 m ²	Yes
Ground Floor	Ex. Stairs	37	9 m ²	Yes
Mezzanine Level	Ex. Change Room	38	9 m ²	Yes
First Floor	Ex. Enclosed Balcony	41	5 m ²	Yes
First Floor	Ex. Circulation	42	26 m ²	Yes
First Floor	Ex. Store Room 12	43	11 m ²	Yes
First Floor	Ex. Store Room 13	44	12 m ²	Yes
First Floor	Ex. Store Room 14	45	8 m ²	Yes
First Floor	Ex. Store Room 15	46	15 m ²	Yes
First Floor	Ex. Stair	48	4 m ²	Yes
First Floor	Ex. Store Room 16	49	15 m ²	Yes
First Floor	Ex. Store Room 17	50	16 m ²	Yes
Mezzanine Level 2	Ex. Change Room	51	9 m ²	Yes
Grand total:		30	360 m ²	

Area Schedule (Rentable) COV.

Level	Name	Rm. No.	Area	Cov.
Wall Plate	Ex. Roof	52	251 m ²	Yes
Grand total			251 m ²	

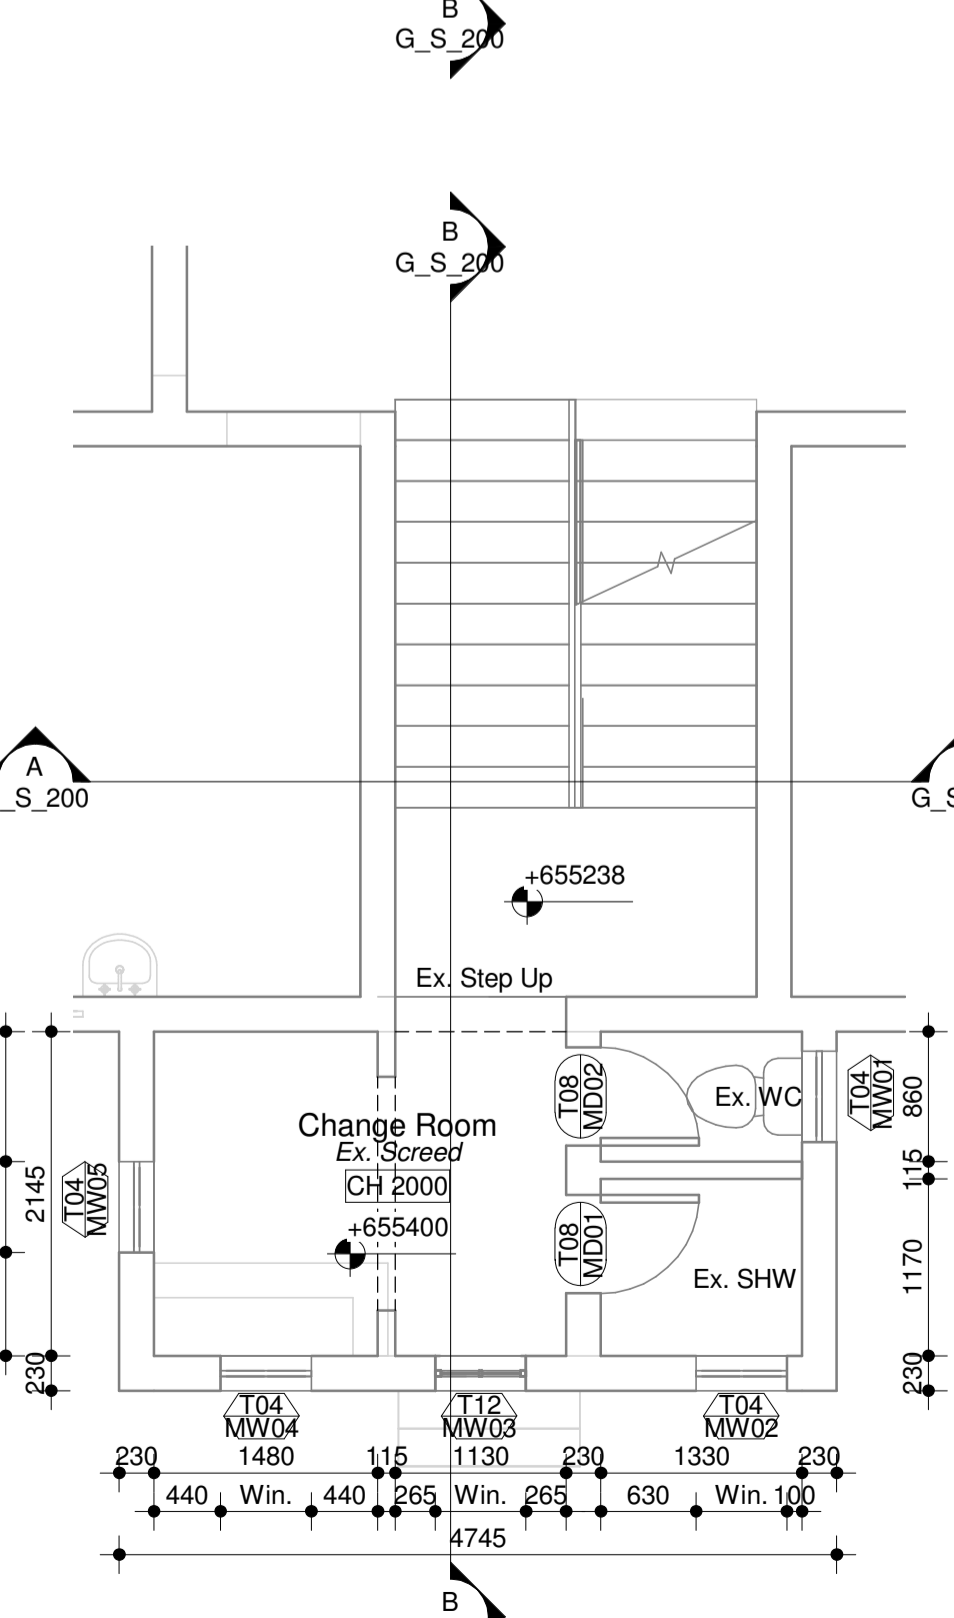

Client: _____

Signature: _____ Date: _____



Project Title: **KZN MUSEUM**

Date: 2020/07/14 12:36:33 Scale: _____

Drawn: CJ

Drawing Description: **BLOCK G - AS-BUILT BASEMENT, GROUND FLOOR AND MEZZANINE LEVEL**

Job no.: S511 Drawing no.: G_P_100 Rev. no.: _____

- ISSUED FOR APPROVAL
- ISSUED FOR INFORMATION
- ISSUED FOR SUBMISSION
- ISSUED FOR TENDER
- ISSUED FOR CONSTRUCTION