


DASHED RED LINE INDICATES POWERLINE ROUTE

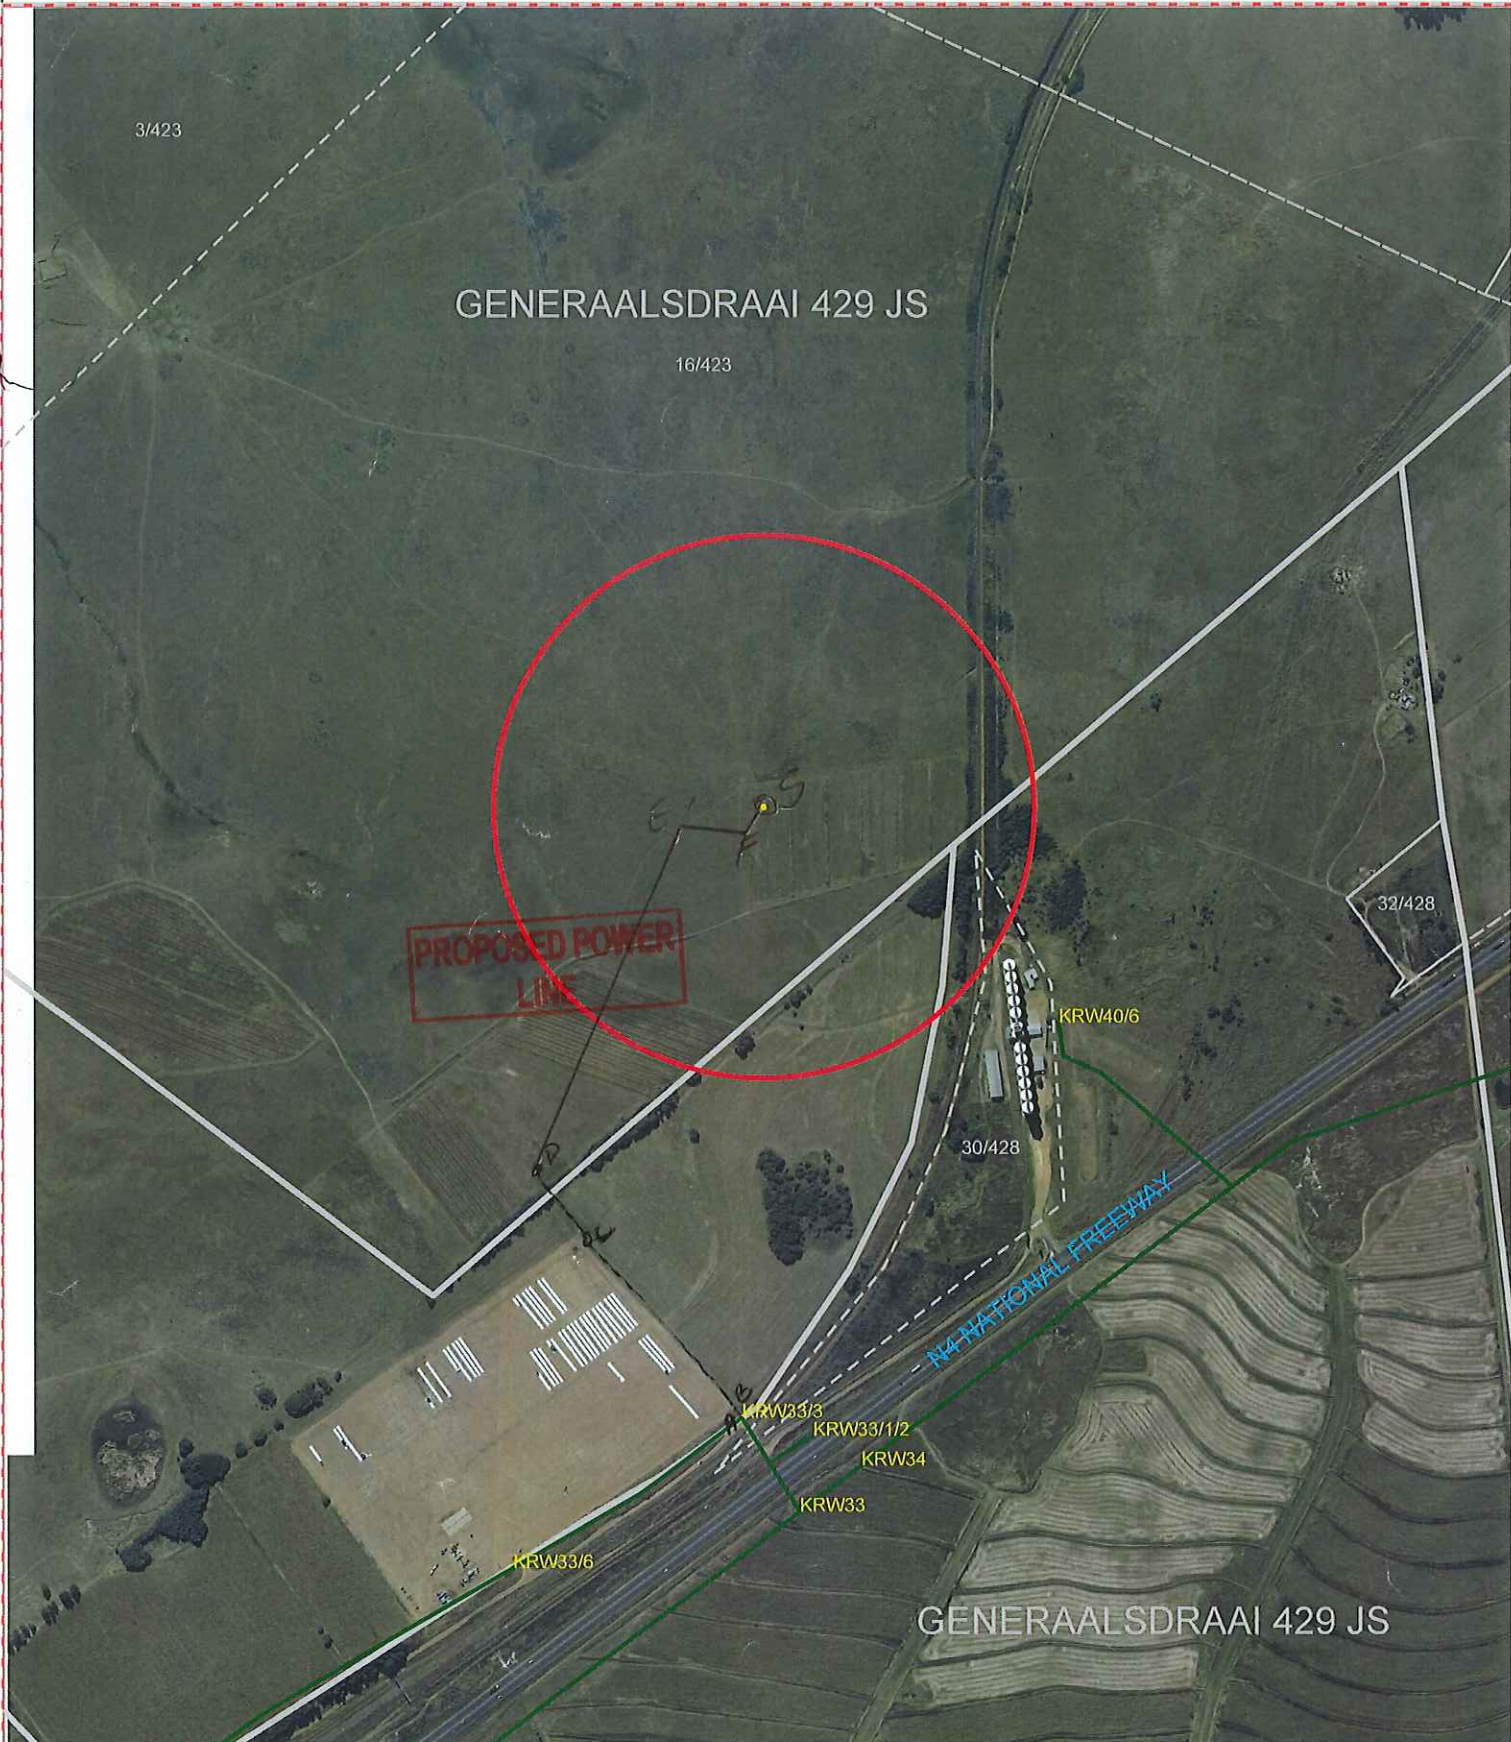

Wayleave
Mpumalanga Operating Unit

Property description:

Disclaimer
Geographic information displayed
is not responsible for any errors
in external datasets displayed
on this map

Registered Owner: _____

Eskom: _____

Project No: WP149763553B

Witness: 1. _____

Witness: 1. _____

Date: _____

Witness: 2. _____

Witness: 2. _____

Portion of map no: 2529 DD N

Scale: 1:10 000

