
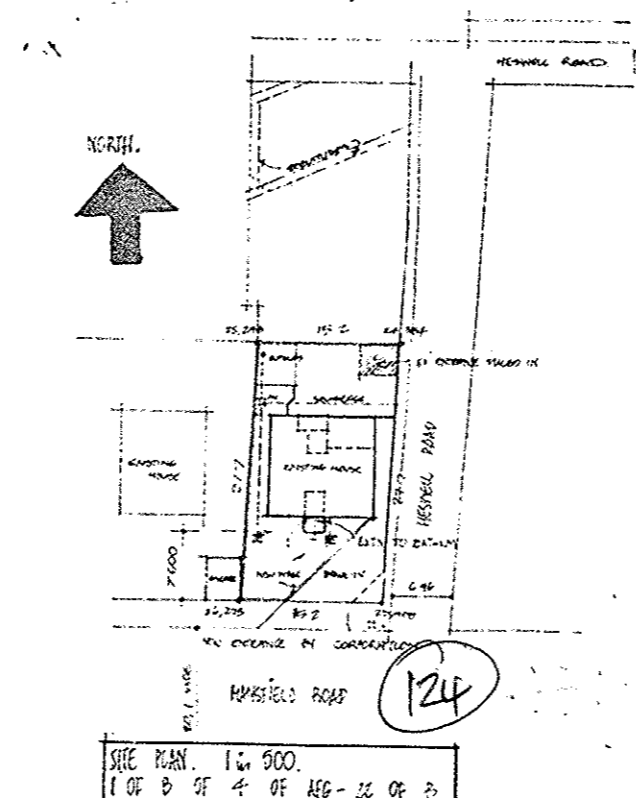
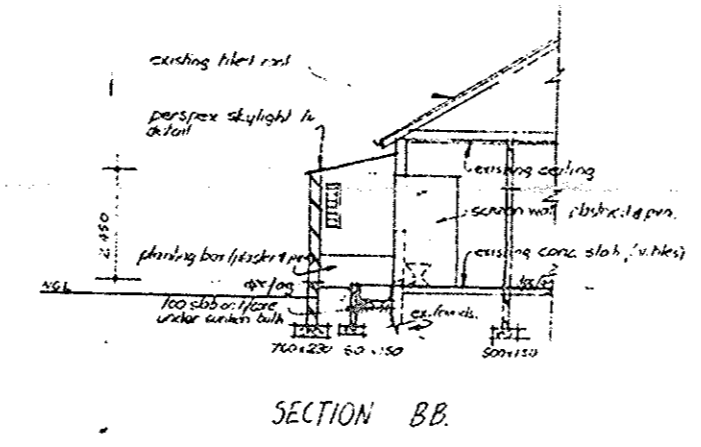
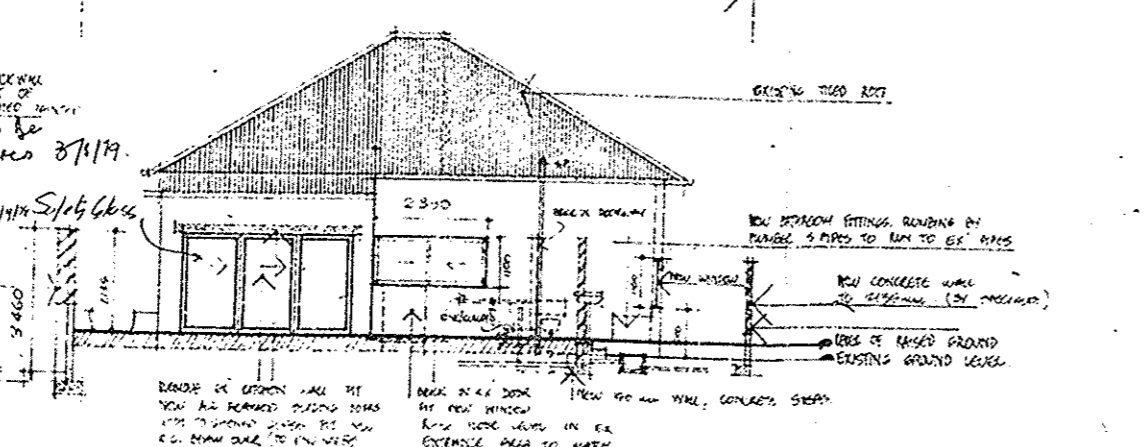
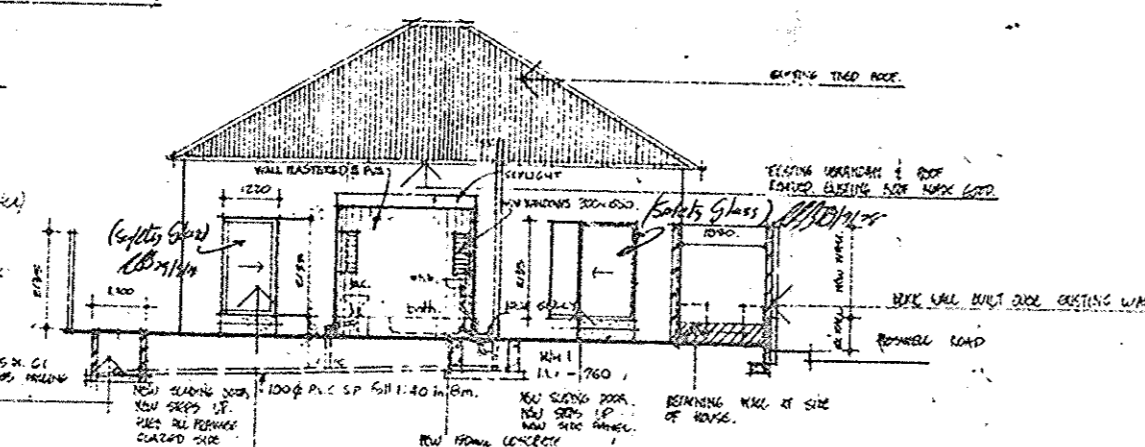
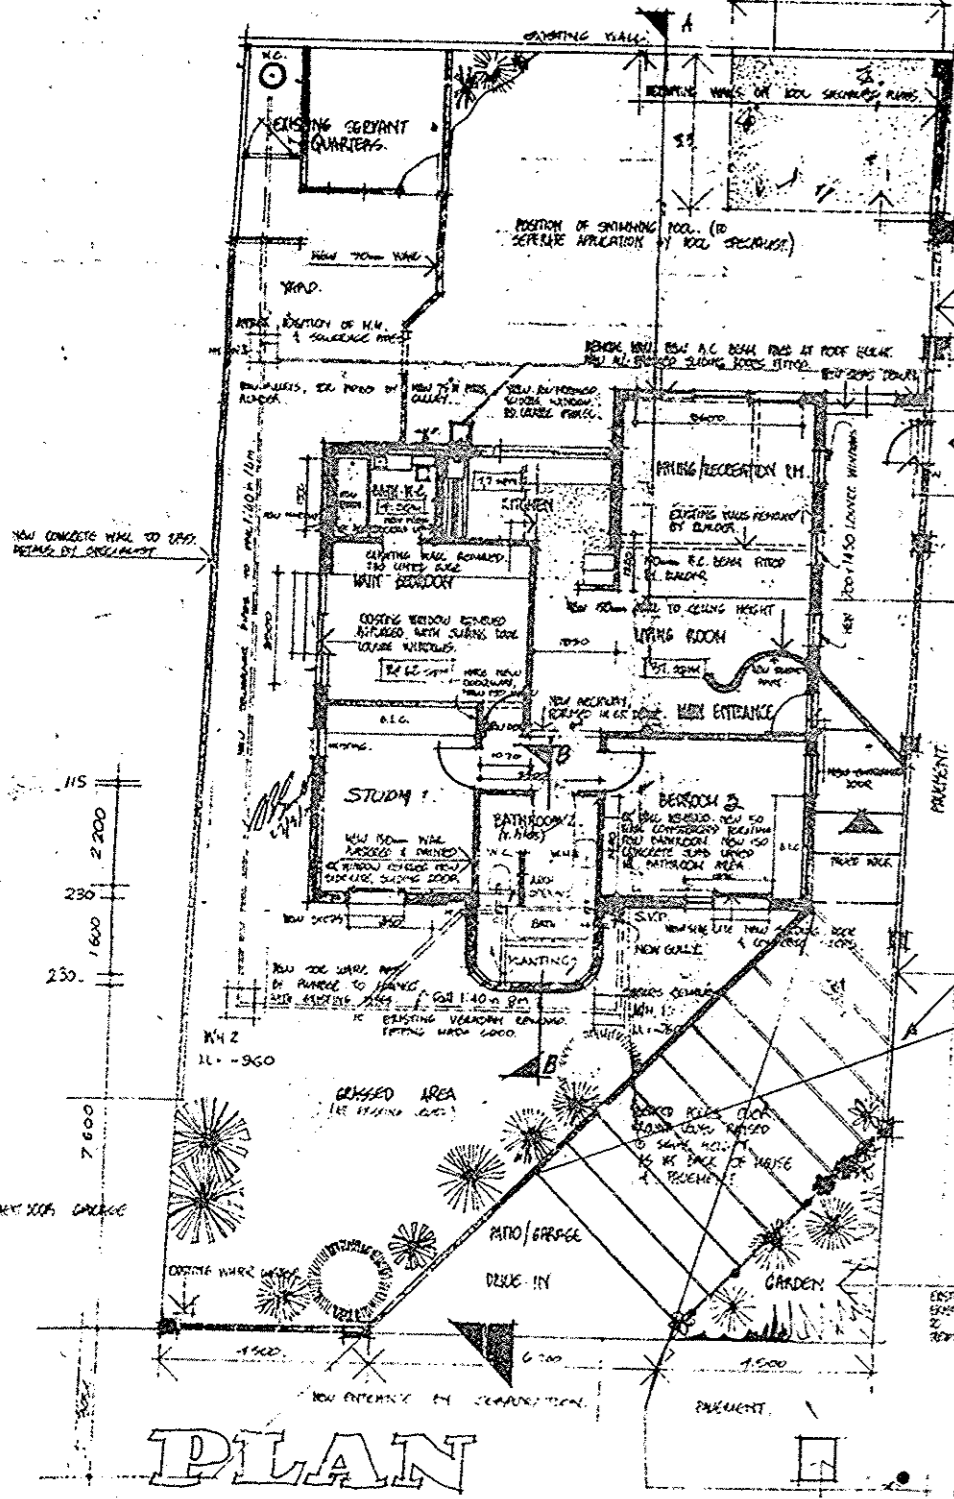
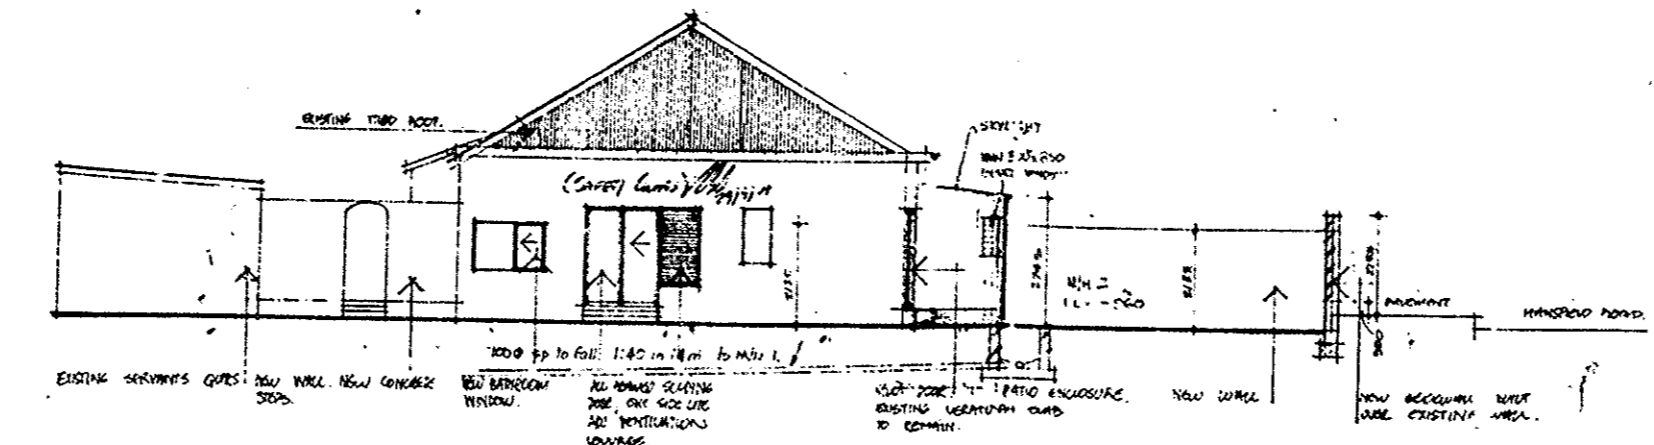


SHEET // COPY 3
 CITY OF DURBAN
 PLAN NO. 441/8/78
 APPROVED 22 FEB 1978
 B.G. MACKAY
 CITY ENGINEER

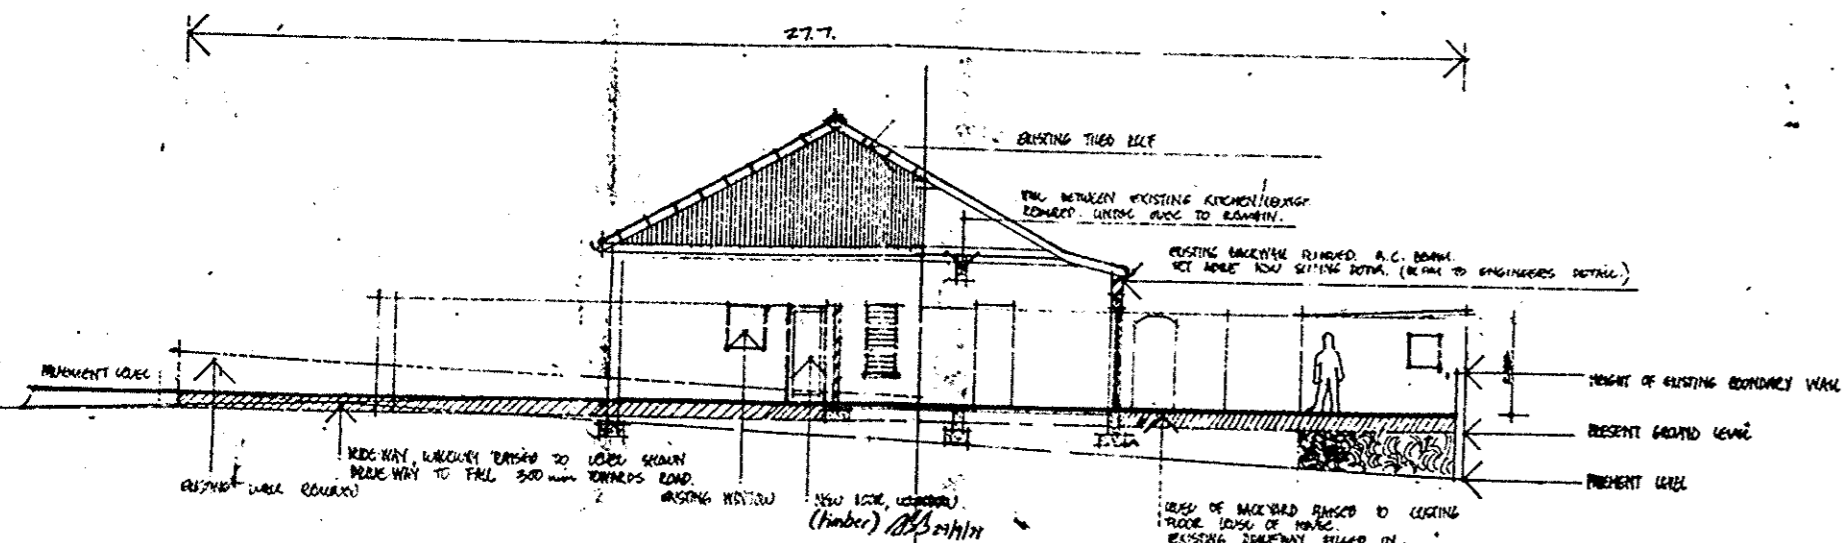

TOWN PLANNING SECTION
 APPROVED
 DATE 1978-8-30
 SIGNATURE

INCORPORATING APPROVED PLAN
 No. 441/76 APP. 20/1/76
 No. 441/77 APP. 24/1/77
 No. APP.
 No. APP.
 No. APP.

AS BUILT

- LIST OF AMENDMENTS TO APPROVED PLAN 441/77/78
- BATHROOM 2 LAYOUT CHANGED - DIMENSIONS OVER EXTENSION - DIMENSIONS CHANGED
 - WINDOWS ON EAST WALL OF LOUNGE/DINING CHANGED TO 900x1450 LOUNGE
 - POSITION OF DOOR TO LITINEN CHANGED
 - KITCHEN WINDOW CHANGED

ORIGINAL HOUSE BUILT 1927
 INCREASE IN FLOOR AREA 5.4 m²

ALTERATIONS TO HOUSE AT 124 MANSFIELD ROAD FOR MR. B. TURNBULL

WALLS IN COMPLIANCE WITH LAMBERT RD - SIZE 1.4m x 2.0m - 12-18-1926 - APPROVED BY MR. G. S. T. A. S. A.

AMENDMENTS BY :-

1927 =

