

GOVERNMENT NOTICES GOEWERMENTSKENNISGEWINGS

DEPARTMENT OF ARTS AND CULTURE DEPARTEMENT VAN KUNS EN KULTUUR

No. 549

8 July 2011

SOUTH AFRICAN HERITAGE RESOURCES AGENCY

DECLARATION OF THE "VOORTREKKER MONUMENT", FARM GROENKLOOF, SITUATED ON CERTAIN PORTIONS OF PORTION 12, 13 AND 24/R OF FARM 358-JR, PRETORIA AS A NATIONAL HERITAGE SITE

By virtue of the powers vested in the South African Heritage Resources Agency in terms of section 27(5) of the National Heritage Resources Act, 25 of 1999, SAHRA hereby declares the "Voortrekker Monument" situated on the Farm Groenkloof, on certain portions of Portions 12, 13 and 24/R of farm 358-JR, Pretoria and all associated heritage objects, as a National Heritage Site.

SIGNIFICANCE

This sight is architecturally renowned for its Art Deco style designed by well known South African architect, Gerhard Moerdyk. The monument was constructed between 1937 and 1949. The Voortrekker Monument commemorates the mass movement of people who are of Afrikaner descent from the Cape Colony between 1834 to 1838. The monument portrays and focuses on 16 December 1838 when the Zulu Army of Dingane was defeated and the course of history of the interior was altered.

The Voortrekker Monument was officially opened on 16 December 1949. In addition to the history of the mass movement, the Monument serves to remind South Africans of the epitome of Afrikaner Nationalism. Forming part of the South African political history landscape, which has had an undeniable effect on the way in which the new democratic South Africa has developed.

DESCRIPTION

The following falls within the protected area

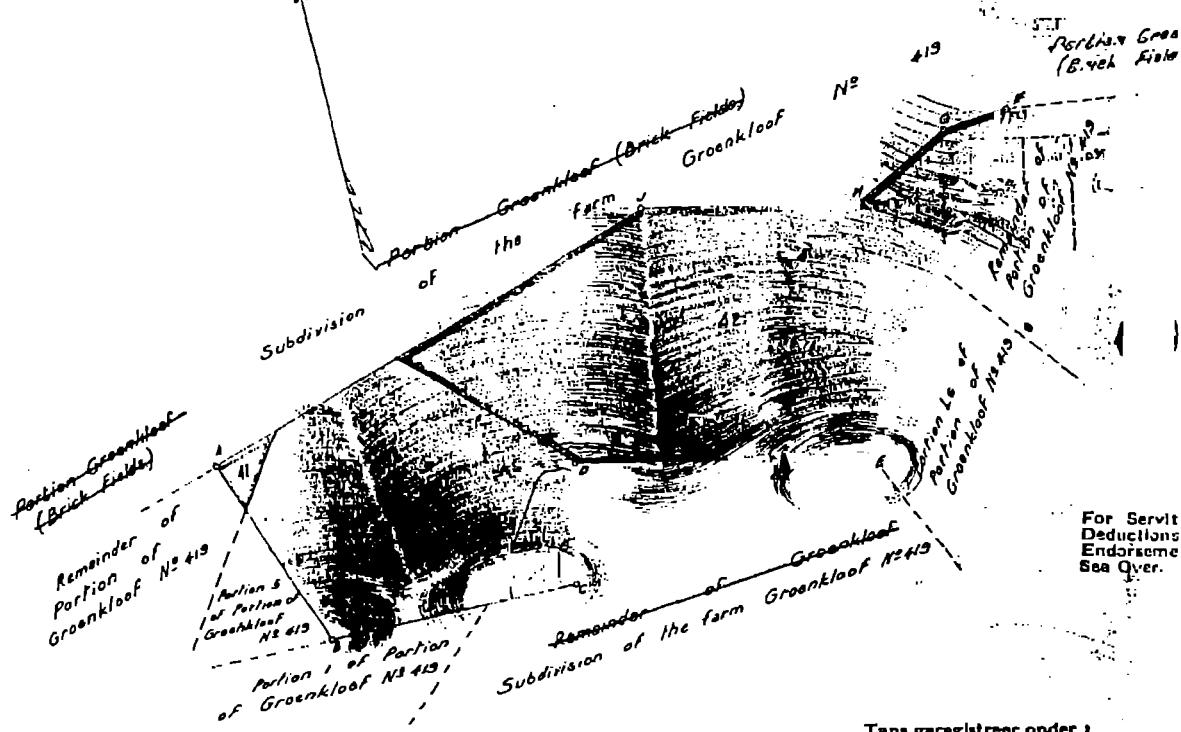
	ERF NOS.	SITE NAME	OWNER	TITLE DEED	EXTENT
1	Certain portions of Portions 12, 13 and 24/R of farm 358-JR	GROENKLOOF	Voortrekker Monument	T13777/1994	15 ha

S.G. NO. A. 1211/44

Approved

[Signature]
Surveyor General

SIDES Code and Block	ANGLES	SYSTEM COORDINATES	CONSTANTS
AB 104-64	A 89° 6' 10"	A - 825-27 - 48-07	
BC 183-73	B 103-44-0	B - 923-88 - 73-48	
CD 60-72	C 103-33-50	C - 924-97 - 203-19	
DE 143-47	D 263-7-20	D - 866-07 - 217-35	
EF 185-85	E 110-59-20	E - 839-01 - 157-63	
FG 11-81	F 91-50-10	F - 745-06 - 462-04	
GH 85-19	G 156-58-40	G - 747-27 - 480-31	
HJ 106-89	H 219-55-10	H - 772-33 - 381-31	
J1 244-29	J 148-46-20	J - 748-44 - 276-31	

Trans geregistreer onder t
Now registered under tNo. 358
REGISTRASIE AFDELING JR
REGISTRATION DIVISION JR

Scale 1 inch = 50 C.Rods.

The figure A. B C. D. E. F. G H J. A.

represents 73 Morgen 235 Square Rods

Portion 24 (or portion of portion)

of land being of the farm GROENKLOOF N° 419.

situate in the DISTRICT of Pretoria

PROVINCE OF TRANSVAAL

Surveyed in July 1905

by Mr

W.A. LARSEN
Land SurveyorDrawn by the direction of the Surveyor General
under the provisions of Section 39 of Act No 3 of 1907.

This diagram relates to Deed of

The original diagram is No. 1211/44/05

No.

relating to Deed of Transfer

in favour of

No. 1211/44/1 dated

In favour of

In favour of

Magistrate of Deeds.

S.G. File No. SOL/3/1211/44/05

Survey Record No.

Complaint No. 1211/44/9

Lat. South 25° 46 Long East 27° 46'

Degree Sheet No. 19 Pretoria P.D.I.

Published

P.M. Reg. 2002, Johannesburg—12/1/10.

ONDERVERDELINGSKAART
A.R. 84 (b), L.V.P. No. 6 van 1927

L.G. No. A 3001, 38

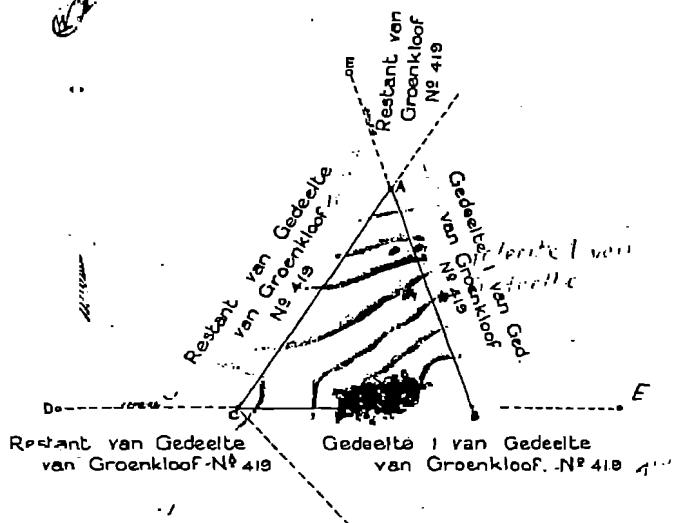
Goedkeur
[Signature]
A.S. Landmeter Generaal
26-7-1938

EYE Rijlings KOKORDINATE
Kapte Voete HOEKES Stelsel Pretoria Plaaslike

AB	943-29	340-24	0	A - 1218-63	9263-05
BC	920-18	89-39	0	B - 1535-05	10151-68
CA	1078-98	214-1-30	C	614-89	10167-30
			D	1145-60	10168-06
			E	1114-12	8969-56

Beskrywing van Bakens.

- A.C.D. is beton bakens met pype in die middel.
B. is nie gebaken nie.
E. is 'n ronde baken met 'n pen in die middel.



Tant geregistreer onder : 7
Now registered under :

* Nek in Gedeelte 12
(in gedeelte van Gedeelte 2)

No. 358
REGISTRASIE AFDELING JR
REGISTRACTION DIVISION JR

Die Afgrond A B C
4-7422 Morge grond genoem Gedeelte 5 van Gedeelte
Groenkloof № 419. stel voor
van die plase

geleë in die DISTRIK PRETORIA

Gemaak in April 1938 deur my

PROVINSIE TRANSVAAL

A. S. Landmeter
Landmeter

Hierdie kaart is gehog aan Akte van -

No. gedateer
ten gunste van

Die oorspronklike kaart is No. A 5328/65

gehog aan Akte van Grendbrief
No. 202/07 gedateer

L.G. Omelag No. 804/1/6893/38

Naastukke No. Komplasie No. 22/10. JR 7A-4
Bulder Breedte 25°46' Ooster Langt 26°10'

Pretoria, P17

f.g. Plan 43 91

ONDERRICHTSBLADSKAART
Art. 21 (b) van die Acte van 1927

L.G. No. A. 3002, 38

Doedgekuur

A.C. Landmeter-General.

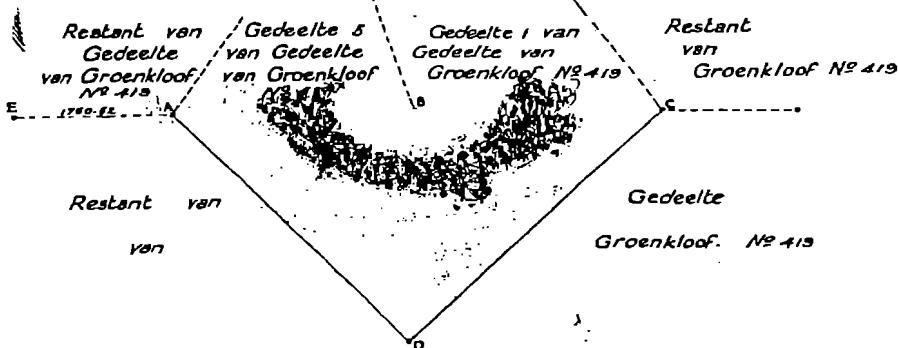
21 JUNI 1938

BYE
Kusse Veld.RIGTING
HOEK.KOÖRDINATE
stad Pretoria Plaaslik

AB 920-18 269-39 0 A - 614-89 +10157-30
 BC 937-39 270-7-50 B - 1535-05 +10151-68
 CD 1342-62 48-0-40 C - 2472-38 +10153-82
 DA 1287-54 136-10-40 D - 1506-40 +11086-25
 E +1145-60 +10168-08

Beskrywing van Bakens.

A.C.D.E. is beton bakens met pype in die middel.
 B is nie gebaken nie.

Tans opregstreer onder :
Now registered under :

No. 358

REGISTRASIE AFDeling PR
REGISTERED IN THE

(In gedeelte van deelte 5)

804/2/1/38

Die figuur A, B, C, D

10-0485 Morge grond naamlik * Gedeelte-I-van-Gedeelte

stel voor
van die plaas

Groenkloof № 419.

gelees in die DISTRIK PRITORIA

Gemset in April 1938 deur my

PROVINSIE TRANSVAAL

A. T. Coetzee
Landmeter.

Hierdie kaart is gelig aan Akte van

No. gedateer

ten gunste van

17686/49
Registrasie van Akte.

Die ooreenkomstige kaart is No. A 228/00

gedateer

No. 228/00 gedateer

ten gunste van

L.G. Omstek. No. 804/2/1/38

Naastukke No.

Komplisie No. 228/00 J.A. 1/1/1

Bulder Breedte 25°46' Ooster Langt 28°10'

Pretoria P 17