



AREA : 15,84 SQ. M.

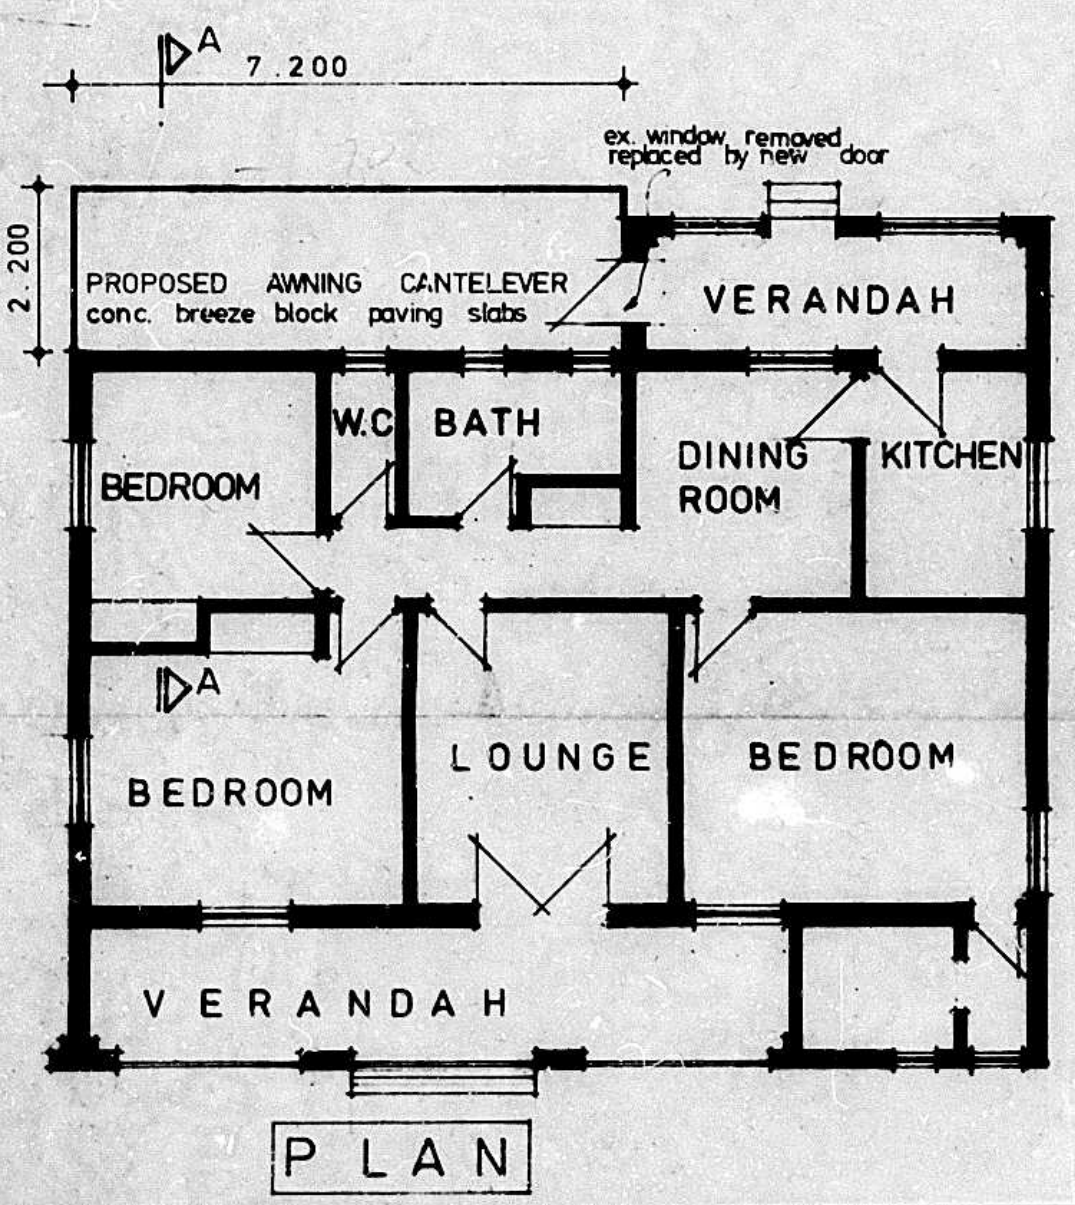

SITE PLAN
SUB 344 OF BLOCK
E UMBILO.

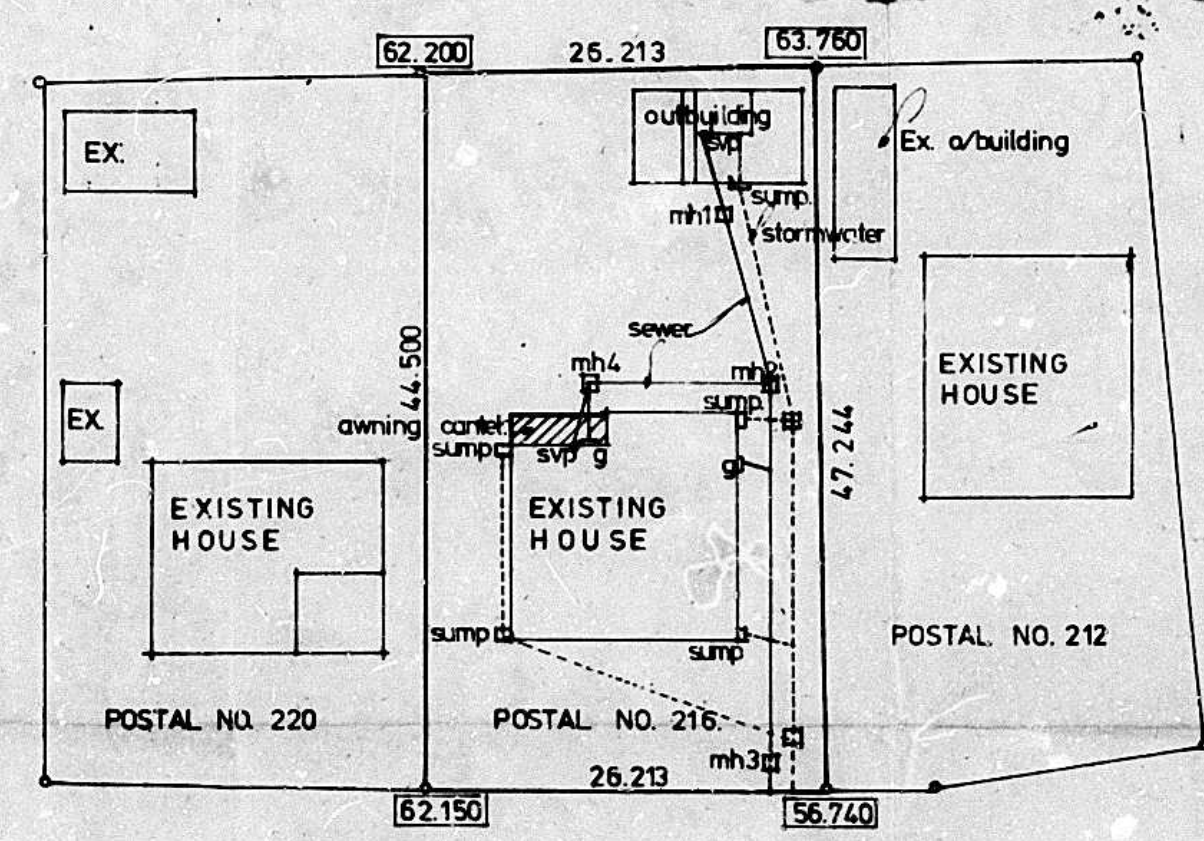

QUEEN MARY AVE. WIDTH 8.000

SHEET 1/1 COPY 3

CITY OF DURBAN
PLAN No. 596/3/77

APPROVED
DATE 7 APR 1977
D.C. MACLEOD
CITY ENGINEER PER [Signature]

TOWN PLANNING SECTION
APPROVED
DATE 1 APR 1977
SIGNATURE [Signature]

IMPORTANT
APPLICATION FOR REFUND OF PORTION OF BUILDING FEES ON ABANDONED PLANS MUST BE RECEIVED BY THE CITY ENGINEER'S DEPARTMENT BEFORE FOURTEEN (14) DAYS PRIOR TO THE EXPIRY DATE OF APPROVAL OF THIS PLAN.

ORIGINAL
AS BUILT
Date 7-11-77.

PROPOSED AWNING CANTELEVER
FOR MR. I. J. A. BRITZ
216 QUEEN MARY AVE. UMBILO.

DATE FEB 1977
SCALE 1:100,500
DRAWN n.b.
CHECKED [Signature]
DRAWING NUMBER

DURBAN DRAWING OFFICE SUITE 20 TIVOLI HOUSE 110 VICTORIA ST. DURBAN PHONE 62097