




SECTION D-D

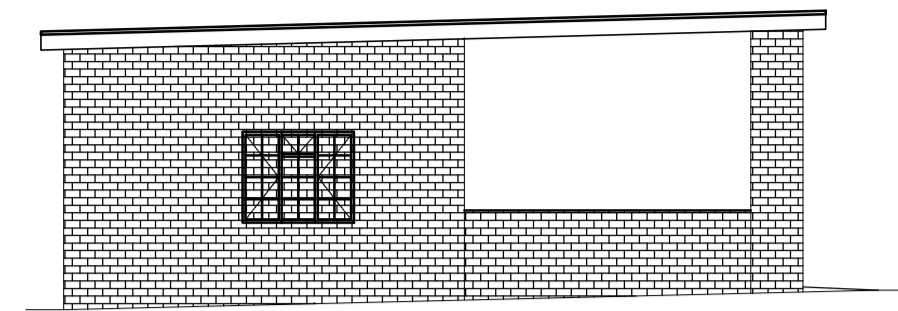


EASTERN ELEVATION

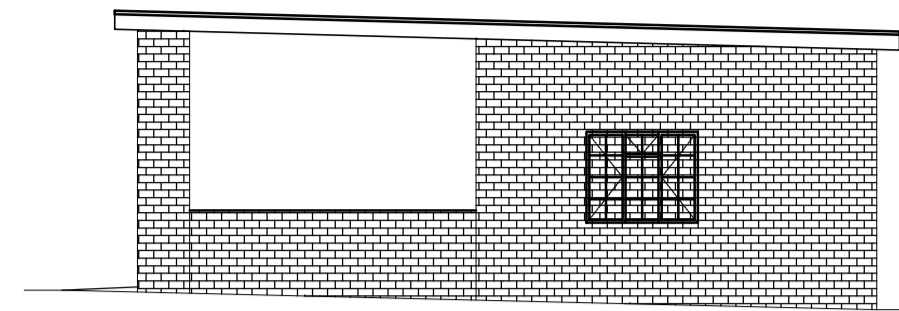


WESTERN ELEVATION

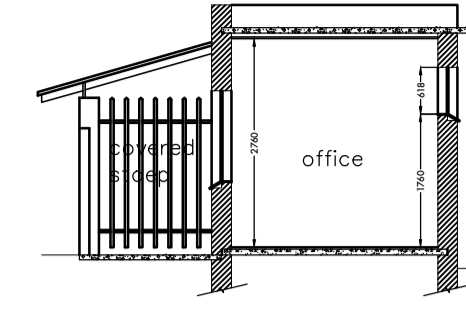


SECTION C-C

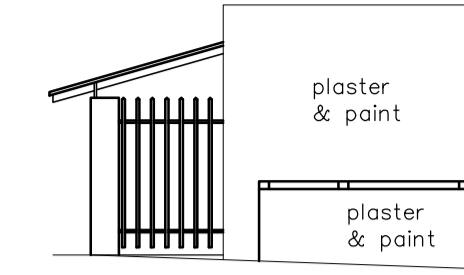


WESTERN ELEVATION

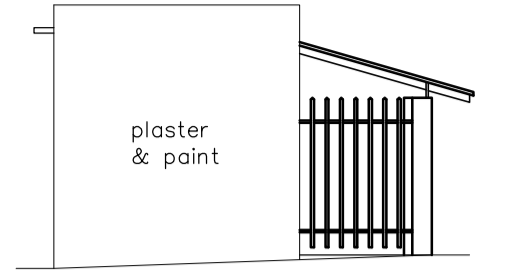


EASTERN ELEVATION

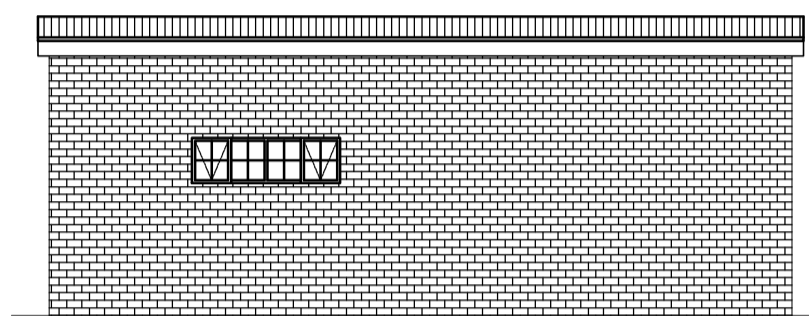


SOUTHERN ELEVATION

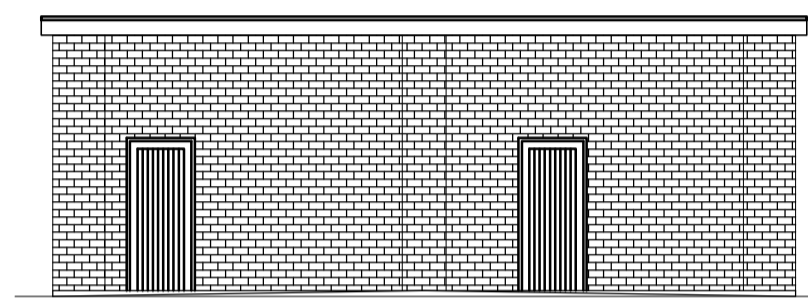

NORTHERN ELEVATION

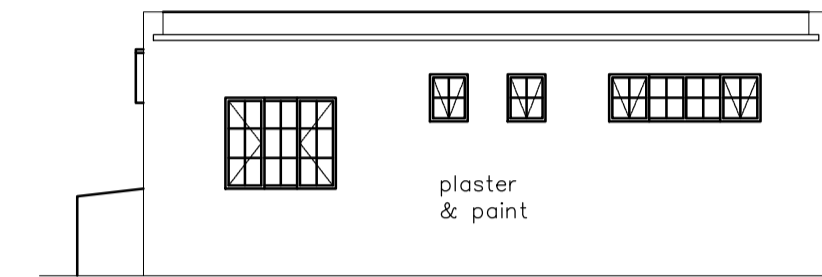

SOUTHERN ELEVATION

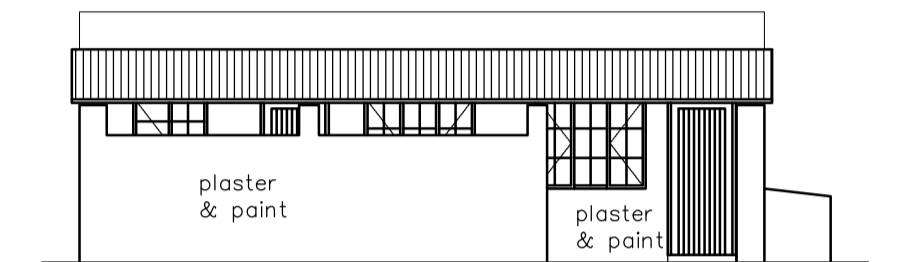


NORTHERN ELEVATION

**Office and covered parking**


1:100

**Garage**


1:100

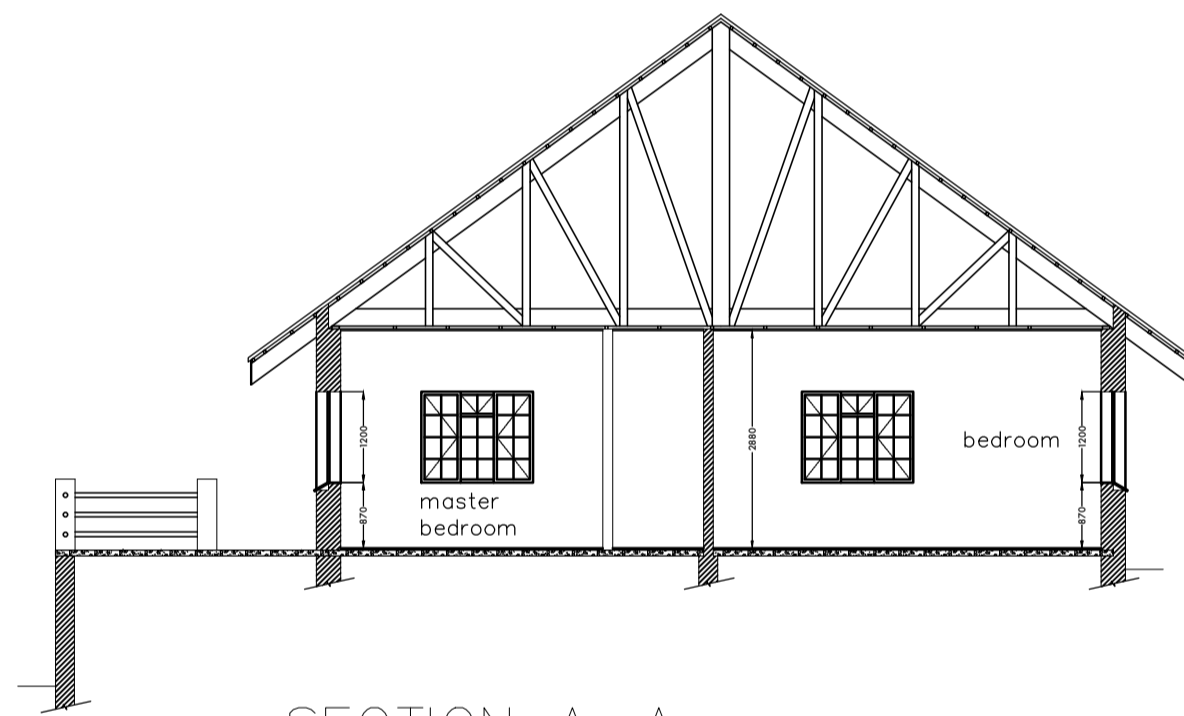


SECTION A-A

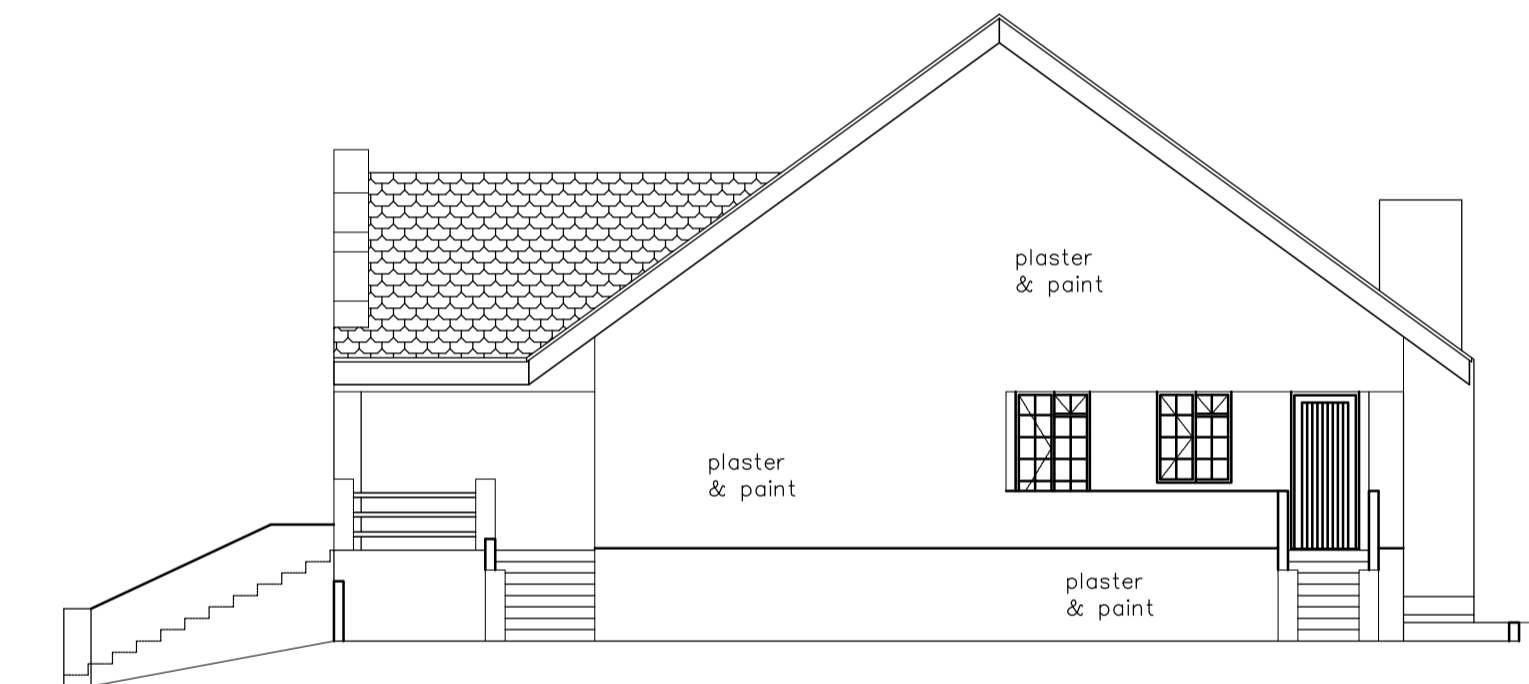

WESTERN ELEVATION

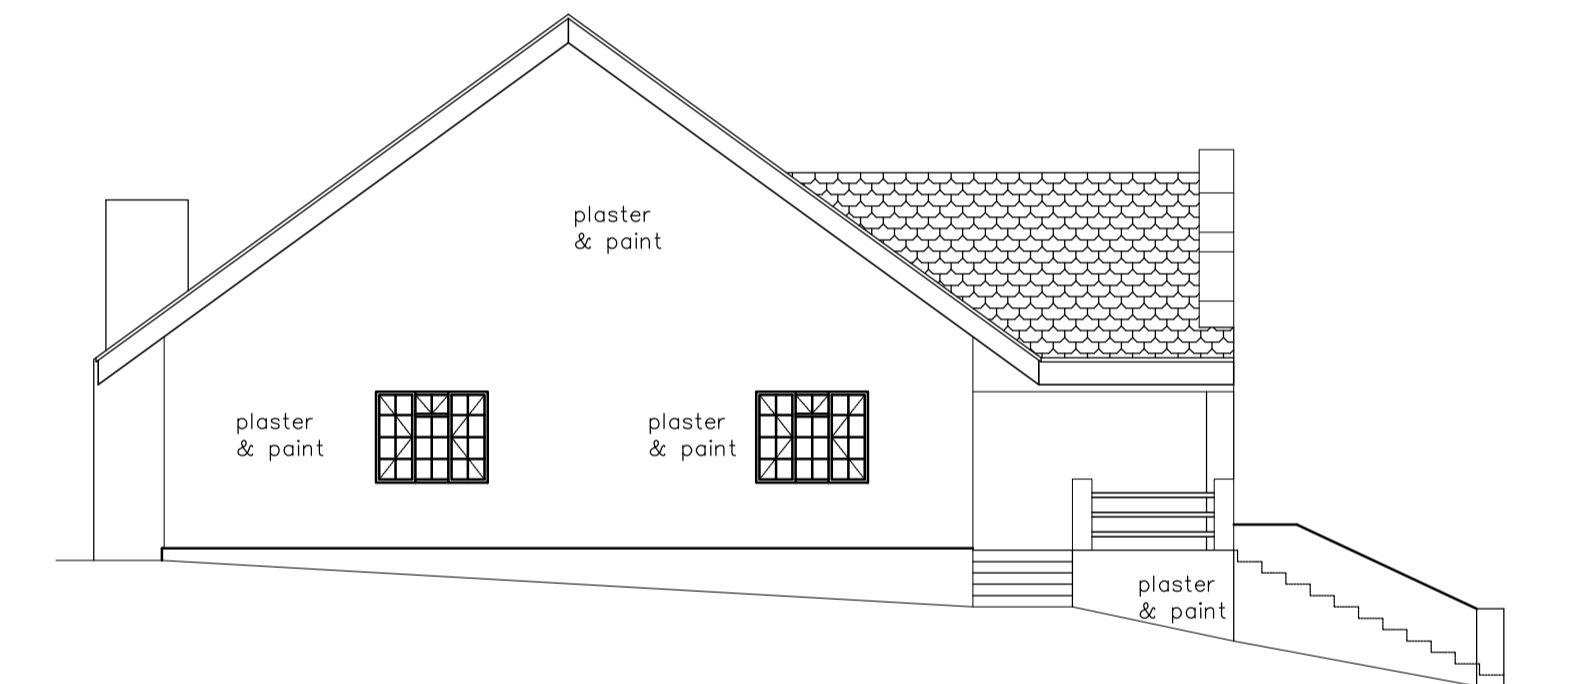

EASTERN ELEVATION

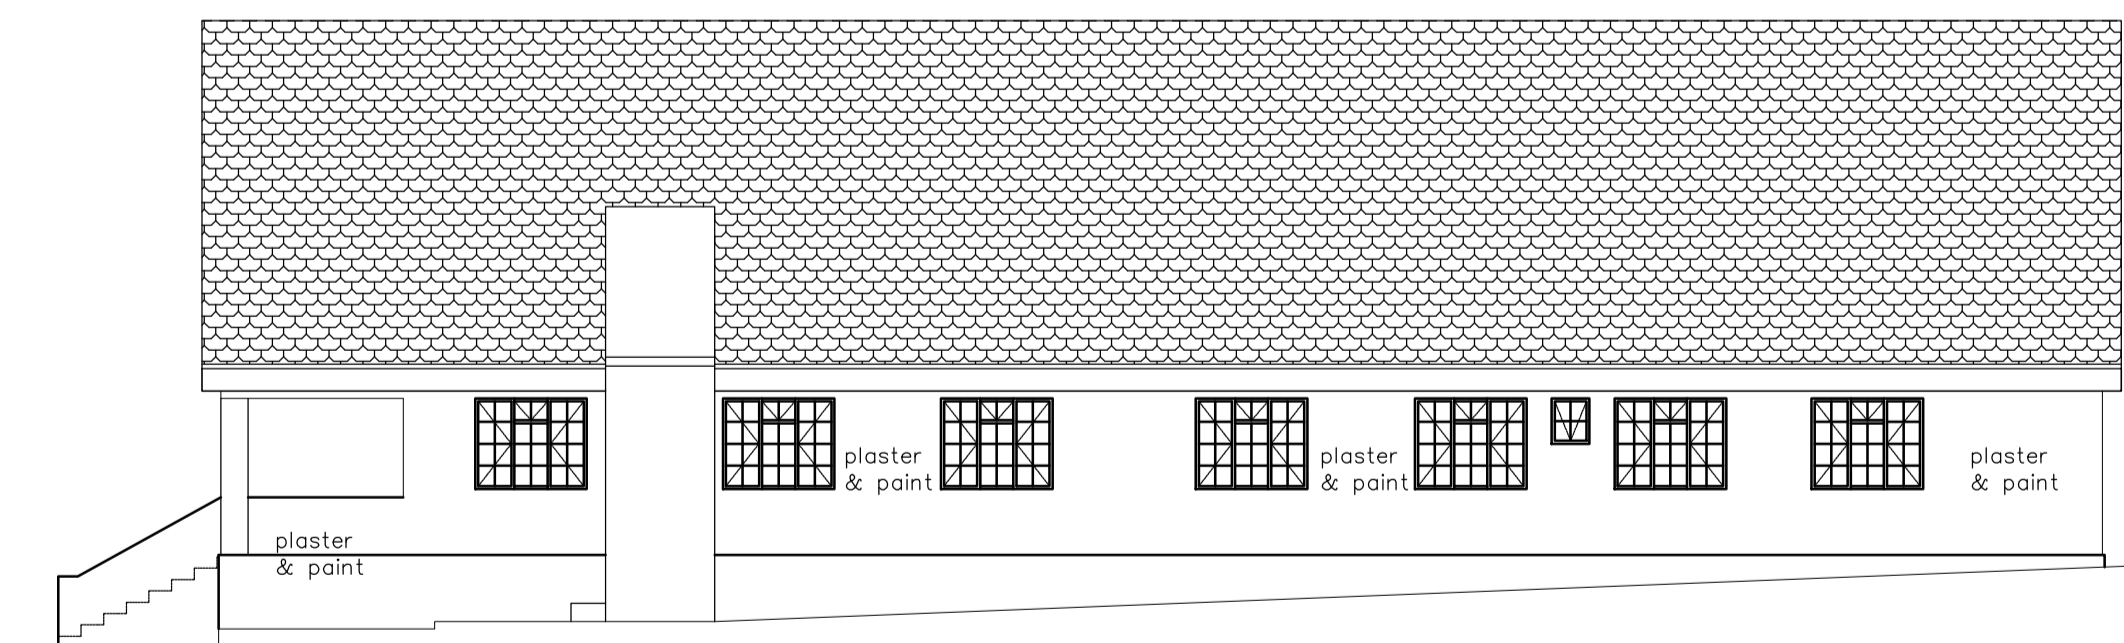

SOUTHERN ELEVATION



NORTHERN ELEVATION

**Main Residence**

1:100



ARCHITECTURE  
ARBITRATION  
HERITAGE  
INTERIOR

PROJECT NAME:

Phase II Heritage Assessment  
of the existing structures on  
portion 662 of the Farm  
Olievenhoutpoort 1961Q

DRAWING TITLE:

As-built drawings

SCALE:	VARIABLES
DRAWN:	EW
DATE:	2017-06-28
STATUS:	AS-BUILT
JOB NO.:	WIEW_0143

DRAWING NO.:	WIEW143_002	REV	0
--------------	-------------	-----	---