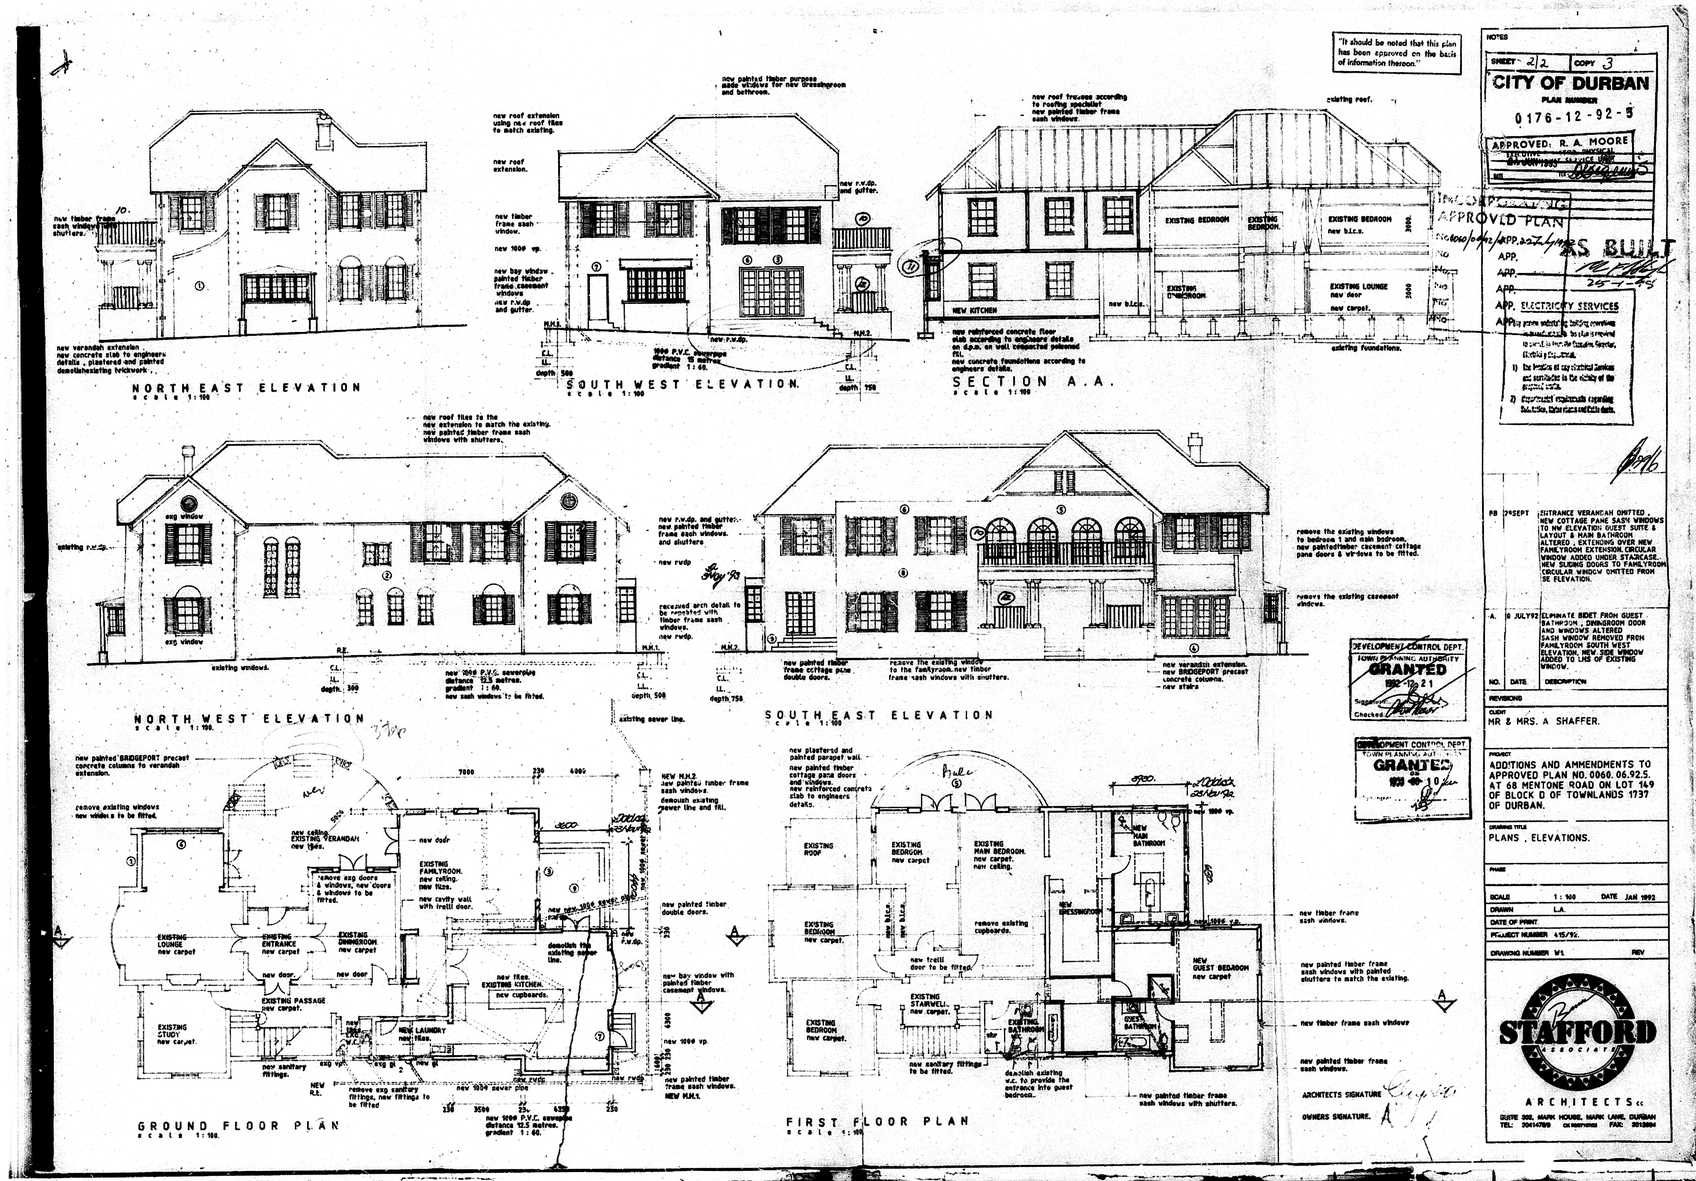

"It should be noted that this plan has been approved on the basis of information thereon."

NOTES

SHEET 2/2 COPY 3

CITY OF DURBAN
PLAN NUMBER
0176-12-92-5

APPROVED: R. A. MOORE
EXECUTIVE OFFICER: BUILDING SERVICES
DATE 30 NOV 1992

APPROVED PLAN
AS BUILT

APP.
APP.
APP.
APP. ELECTRICITY SERVICES
APP.

This plan must be submitted to the Electricity Department for approval by the relevant technical section before any building operations commence.

1) The position of any electrical services not satisfactory to the Authority will be changed at the owners cost.
2) Unprotected materials regarding distance, fabric class and fire rating.

NO.	DATE.	DESCRIPTION
PB	2*SEPT	ENTRANCE VERANDAH OMITTED , NEW COTTAGE PANE SASH WINDOWS TO NW ELEVATION GUEST SUITE & LAYOUT & MAIN BATHROOM ALTERED , EXTENDING OVER NEW FAMILYROOM EXTENSION.CIRCULAR WINDOW ADDED UNDER STAIRCASE. NEW SLIDING DOORS TO FAMILYROOM. CIRCULAR WINDOW OMITTED FROM SE ELEVATION.
A.	6 JULY92	ELIMINATE BIDET FROM GUEST BATHROOM , DINNGROOM DOOR AND WINDOWS ALTERED SASH WINDOW REMOVED FROM FAMILYROOM SOUTH WEST ELEVATION. NEW SIDE WINDOW ADDED TO LHS OF EXISTING WINDOW.

DEVELOPMENT CONTROL DEPT.
TOWN PLANNING AUTHORITY
GRANTED
DATE 1992 11 21
Signed
Checked

DEVELOPMENT CONTROL DEPT.
TOWN PLANNING AUTHORITY
GRANTED
DATE 1993 10 Jan
Signed

REVISIONS

CLIENT
MR & MRS. A SHAFFER.

PROJECT
ADDITIONS AND AMMENDMENTS TO APPROVED PLAN NO. 0060.06.92.5. AT 68 MENTONE ROAD ON LOT 149 OF BLOCK D OF TOWNLANDS 1737 OF DURBAN.

DRAWING TITLE
PLANS , ELEVATIONS.

PHASE

SCALE	1 : 100	DATE	JAN 1992
DRAWN	L.A.		
DATE OF PRINT			
PROJECT NUMBER	415/92.		
DRAWING NUMBER	M1	REV	

STAFFORD ASSOCIATES
ARCHITECTS cc
SUITE 205, MARK HOUSE, MARK LANE, DURBAN
TEL: 304147/8/9 FAX: 3013804

ARCHITECTS SIGNATURE
OWNERS SIGNATURE