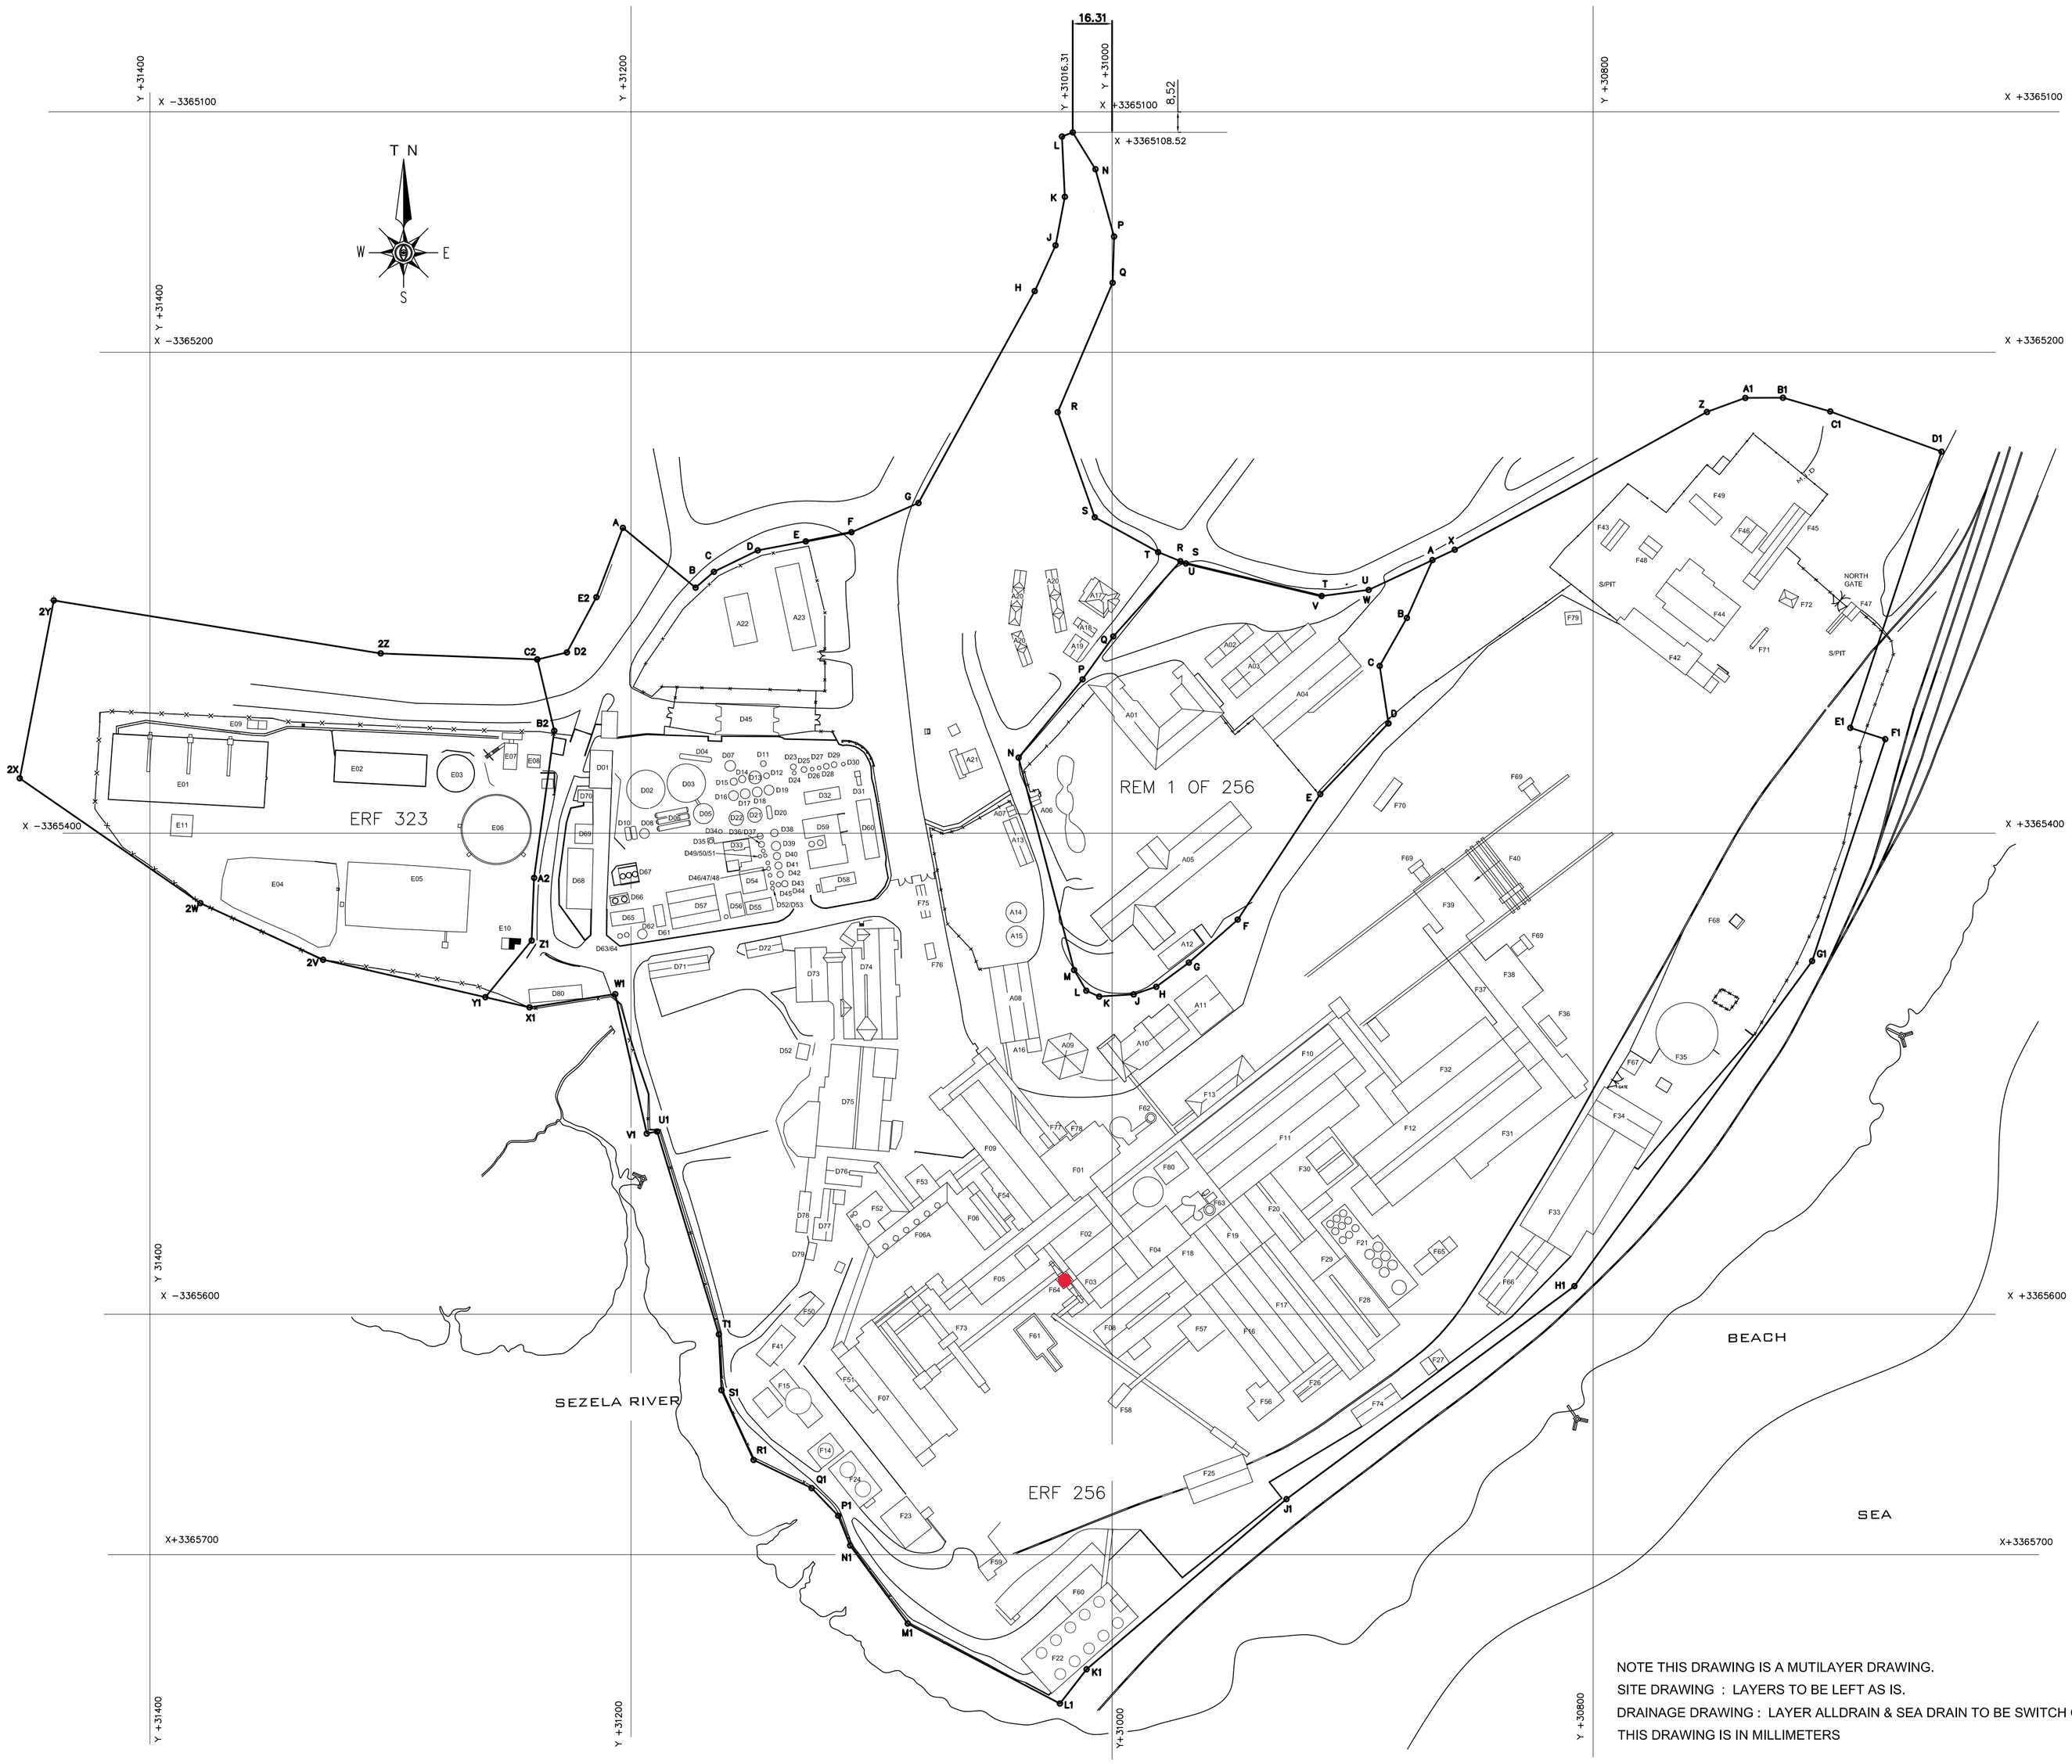

A01	OFFICE-SECURITY/CLINIC
A02	SHADECLOTH PARKING
A03	SHADECLOTH PARKING
A04	OFFICE-AGRICULTURE
A05	OFFICES-ADMINISTATION
A06	SECURITY GATE HOUSE
A07	SECURITY GATE HOUSE
A08	VEHICLE GARAGES & WATER FILTRATION
A09	CONTROL ROOM
A10	CANTEEN/ABLUTIONS
A11	OFFICES AND LABS
A12	VEHICLE GARAGES
A13	VEHICLE GARAGES
A14	FIRE WATER TANK
A15	FIRE WATER TANK
A16	FIRE PUMPS
A17	OFFICES-AGRICULTURE
A18	VEHICLE GARAGES
A19	VEHICLE GARAGES
A20	SHADECLOTH PARKING
A21	OFFICES-AGRICULTURE
A22	VEHICLE COVERED PARKING
A23	VEHICLE COVERED PARKING
E01	AERATION POND
E02	AERATION POND
E03	EFFLUENT CLARIFIER
E04	SLUDGE WASTING POND
E05	CLEAN WATER POND
E06	AERATION TANK
E07	EFFLUENT TREATMENT CONTROL ROOM
E08	CHEMICAL DOSING PLATFORM
E09	TRANSFORMER
E10	TRANSFER PUMP STATION
E11	DEWATERING PLANT
F01	BOILER 1 STEAM GENERATION
F02	BOILER 2 STEAM GENERATION
F03	BOILER 3 STEAM GENERATION
F04	BOILER 4 STEAM GENERATION
F05	PROCESS BUILDING-D/S TROMMELS
F06	PROCESS BUILDING-FURFURAL MANUF
F07	STORAGE SHED-BAGASSE
F08	POWER GENERATION
F09	STORAGE SHED-BAGASSE
F10	MAINTENANCE WORKSHOP
F11	MAINTENANCE WORKSHOP
F12	MILL HOUSE & WORKSHOP
F13	OFFICE-FACTORY
F14	DOWNSTREAM COOLING TOWER
F15	WASTE WATER CLARIFICATION
F16	PROCESS BUILDING-SUGAR MANUFACTURE
F17	PROCESS BUILDING-SUGAR MANUFACTURE
F18	COMPRESSED AIR PLANT
F19	PROCESS BUILDING-SUGAR MANUFACTURE
F20	PROCESS BUILDING-SUGAR MANUFACTURE
F21	PROCESS TANKS -SUGAR MANUFACTURE
F22	COOLING TOWERS - SUGAR FACTORY
F23	EFFLUENT COOLING- D/S MANUFACTURE
F24	COOLING TOWERS - D/S MANUFACTURE
F25	COAL BUNKER
F26	SUGAR STORE
F27	OIL STORE
F28	PROCESS BUILDING-SUGAR MANUFACTURE
F29	PROCESS BUILDING-SUGAR MANUFACTURE
F30	PROCESS BUILDING-SUGAR MANUFACTURE
F31	PROCESS PLANT EAST-SUGAR EXTRACTION
F32	PROCESS PLANT WEST-SUGAR EXTRACTION
F33	WAREHOUSE - STORE
F34	WAREHOUSE - STORE
F35	MOLASSES TANK
F36	TRANSFORMER BUILDING
F37	SHREDDER
F38	PROCESS PLANT EAST - CANE FEED SYSTEM
F39	PROCESS PLANT WEST - CANE FEED SYSTEM
F40	OVERHEAD CRANE GANTRY
F41	COOLING TOWER PUMP STATION
F42	STORE ROOMS
F43	STORE SHED
F44	OFFICES & WORKSHOP-CIVILS
F45	OFFICES & STORE ROOMS
F46	VEHICLE WORKSHOPS
F47	SECURITY GATE HOUSE
F48	MEETING ROOM
F49	STORAGE SHED
F50	ELECTRICAL TRANSFORMER & MCC
F51	ELECTRICAL MCC
F52	PROCESS PLANT-DISTILLATION
F53	PROCESS PLANT-CLARIFICAION
F54	ELECTRICAL MCC
F55	EFFLUENT SUMP & TRANSFER PUMP
F56	LIME STORE
F57	PROCESS BUILDING-SUGAR MANUFACTURE
F58	MAILA STORAGE BIN
F59	STORE ROOM
F60	COOLING WATER PUMP STATION
F61	BOILER ASH RECOVERY POND
F62	BOILER 1 CHIMNEY STACK
F63	BOILER 4 CHIMNEY STACK
F64	BOILER 2 & 3 CHIMNEY STACK
F65	EFFLUENT COLLECTION/PUMP STN
F66	ABLUTIONS
F67	GAS STORAGE
F68	EFFLUENT PUMP STATION
F69	VEHICLE UNLOADING GANTRYS
F70	OFFICES & STORE ROOM
F71	PETROL/DIESEL BOWSER
F72	SHADECLOTH PARKING
F73	RESIDUE DRYER
F74	STORAGE
F75	SECURITY BUILDING
F76	WEIGHBRIDGE
F77	PUMP HOUSE
F78	TRANSFORMER
F79	CANEYARD SHED
F80	BOILER ABLUTION BLOCK
D01	CHANGING ROOM/ABLUTION
D02	FURFURAL STORAGE TANK
D03	FURFURAL STORAGE TANK
D04	METHANOL STORAGE TANK
D05	POLY FUEL STORAGE TANK
D06	SOLVENT STORAGE TANK
D07	RAW SOLVENT TANK
D08	PRIMARY CENTRATE TANK
D09	DIKETONES SPARE 2
D10	RAW PRODUCT STORAGE
D11	PRODUCT STORAGE
D12	PROCESS OIL TANK
D13	FURFURAL STORAGE TANK
D14	LYE TANK
D15	FA 2 112
D16	FA DAY TANK 1
D17	FA DAY TANK 2
D18	FA DAY TANK 3
D19	FF DAY TANK 123
D20	LYE MIXING TANK
D21	FA STORAGE 1161 (SS316)
D22	FA STORAGE 1162 (MILD ST)
D23	MEDS TANK 1
D24	HD/FF VT 029
D25	MEDS TANK 2
D26	HD/FF VT 129
D27	HD/2MF FF VT110
D28	RAW FA VT122
D29	FURFURAL VT101
D30	FURFURAL SPARE
D31	FA 1/2 OIL BURNERS
D32	FA 1 PLANT
D33	2.3 PD & DIACETYL DISTILLATION
D34	POLYMER HOLDING TANK
D35	FURFURAL DOSING PLANT
D36	2.3 PD STARTING MATERIAL TANK
D37	2.3 PD STARTING MATERIAL TANK
D38	LP H2 STORAGE TANK
D39	RAW FA TK 622
D40	2MF/FF FA TK 610
D41	FF TK 601
D42	FA/FF TK 609
D43	ME SULVENT VT 632A
D44	2MF VT 625
D45	CHEMICAL LOADING BAY
D46	VT 121A
D47	VT 121B
D48	ACID WATER TANK
D49	2.3 PD TANK
D50	2.3 PD TANK
D51	4T DECANTER
D52	SEWAGE PUMPHOUSE
D53	VT 122
D54	DAIL 2 PLANT
D55	CRYSTALLIZER PLANT
D56	COMPRESSOR ROOM (DS)
D57	DRUM STORE / ACETOIN PLANT
D58	FA 2 PLANT
D59	BBC PLANT
D60	CONTROL ROOM / HT SUB STATION
D61	TRANSFORMER ROOM
D62	EFFLUENT TANK
D63	H.F.O TANKS
D64	2MCC ROOM
D65	BOILER STEAM GENERATION
D66	COOLING TOWERS (DS)
D67	COOLING TOWERS (DS)
D68	STORAGE SHED
D69	STORAGE SHED
D70	LAUNDRY ROOM
D71	VEHICLE-GARAGES
D72	VEHICLE-GARAGES
D73	OFFICES-DOWNSTREAM
D74	OFFICES & LABORATORY- D/S
D75	MAINTENANCE WORKSHOPS
D76	ABLUTIONS & CHANGE ROOMS
D77	ABLUTIONS & CHANGE ROOMS
D78	FACTORY OFFICE & REST ROOM
D79	CHEMICAL STOREROOM
D80	VEHICLE-GARAGES

NOTE THIS DRAWING IS A MUTILAYER DRAWING.
SITE DRAWING : LAYERS TO BE LEFT AS IS.
DRAINAGE DRAWING : LAYER ALLDRAIN & SEA DRAIN TO BE SWITCH ON
THIS DRAWING IS IN MILLIMETERS

SITE LAYOUT	DRAINAGE	
SEZELA ERF 256	SEZELA REM 1 OF 256	SEZELA ERF 323

DRG.No.	REFERENCE DRAWINGS	REV	NAME	DATE	DESCRIPTION	APPROVED
			C.C.V	3/4/11	AS-BUILT SITE PLAN	

NOTES

THIS DRAWING WAS COMPILED ESPECIALLY FOR THE PURPOSE OF PROVIDING THE UMDONI MUNICIPALITY WITH A RECORD OF ALL BUILDINGS AND IMPROVEMENTS ON ERF 256, REMAINER 1 OF 236, AND ERF 323 SEZELA

NO CHANGES MAY BE MADE TO THIS DRAWING WITHOUT THE WRITTEN AUTHORIZATION OF THE ADMINISTRATION MANAGER OF ILLOVO SEZELA

PATH:

COPYRIGHT RESERVED

THIS DRAWING IS THE PROPERTY OF THE COMPANY & MAY NOT BE DISCLOSED TO THIRD PARTIES OR REPRODUCED EITHER WHOLLY OR PARTLY WITHOUT THEIR CONSENT.

SUGAR ILLOVO LIMITED
SEZELA–DOWNSTREAM PRODUCTS

STATUS	MAJOR	SUB	SUB	MAJOR PLANT	DRAWING TYPE	PLANT NUMBER	DRAWING NUMBER	I.D.	MICROFILM NUMBER

DO NOT SCALE – IF IN DOUBT ASK

TITLE: AS-BUILT SITE LAYOUT
SEZELA ERF 256 / SEZELA REM 1 OF 256 &
SEZELA ERF 323 AS OF 1st DECEMBER 1999

DRAWN:	DATE:	SCALE:	CHECKED:	PASSED:	APPROVED:	DRG.No.	REV.
C.C.VENNELL	29/03/2011	1=1000				13091	0