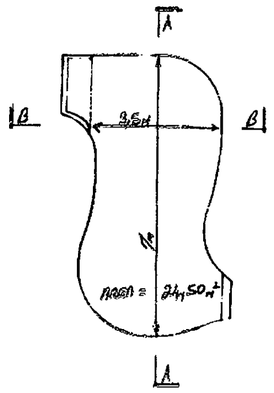

PLAN OF POOL 1:100

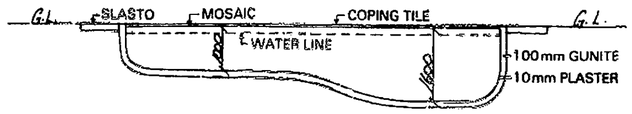

SECTION A-A

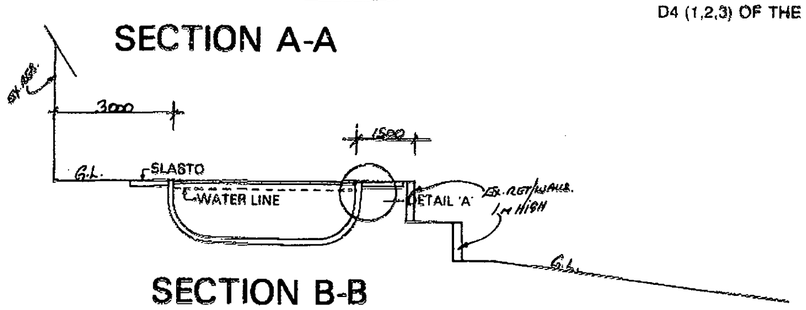

SECTION B-B

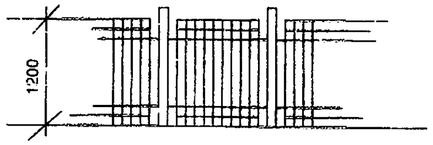

PART ELEVATION OF POOL FENCE. POOL AREA TO BE FENCED IN ACCORDANCE WITH PART D4 (1,2,3) OF THE N.B.R., SABS (1390)

A. The author of the plan is responsible for:-
(a) showing on the applicant drawings
(i) the access level of every inlet of SC sewers, [illegible] and/or chambers of discharge points;
(b) the tops of foundation of any drainage works at a minimum depth of 0.250 metres below finished ground level.
(c) [illegible] over SC servitudes or SC access chambers.
B. [illegible]
(a) no closer to the back of the constructed sidewalk as
(b) to be calculated by the [illegible] following formula:- FL = 0.50m + D / 25
(where FL = [illegible] and D = [illegible] but not less than 1000 mm and not more than 2400 mm, measured from road reserve boundary)
C. A concrete kerb at the corner [illegible] level is to be [illegible] grade as the kerb or road.
D. No change in [illegible] or SC underground services [illegible] without the prior written approval of the Executive Director (Physical Environment)"

NOTES:
1. Earth Leakage relay to be stored in Electrical Circuit.
2. Precautions to be taken in regard to condensation.
3. Pump Chamber to be adequately drained.
4. Electrical Equipment to be simmarly housed precautions taken in regard to condensation.
5. Waste Water to be ~~spread on site~~/via B.P.T. to open channel sewer manhole.
6. Soil to be spread on Site. ~~(Carted Away)~~.
7. Pool Area to be fenced in accordance with Part D4 (1,2,3) of the N.B.R. SABS (1390)

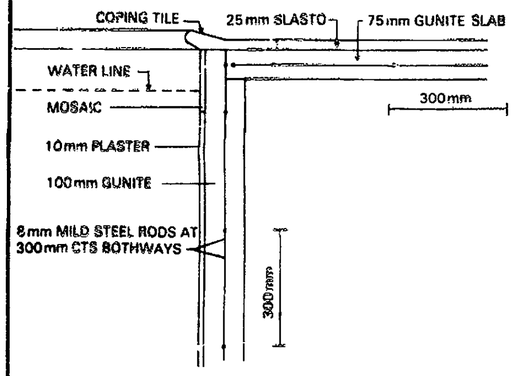

DETAIL "A" 1:10

IMPORTANT

THE APPLICANT IS RESPONSIBLE FOR ASCERTAINING THE POSITION OF ALL POST OFFICE CABLES OR OTHER PLANT AND WILL BE LIABLE FOR ANY COST ARISING DUE TO DAMAGE TO OR THE NEED FOR RELOCATION OF SUCH PLANT ARISING OUT OF WORK INDICATED ON THIS APPLICATION.

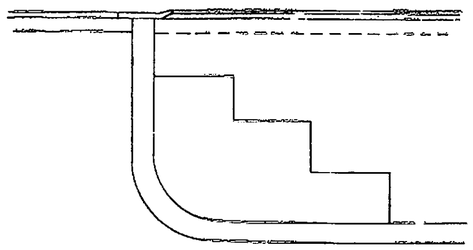

STEP DETAIL 1:20

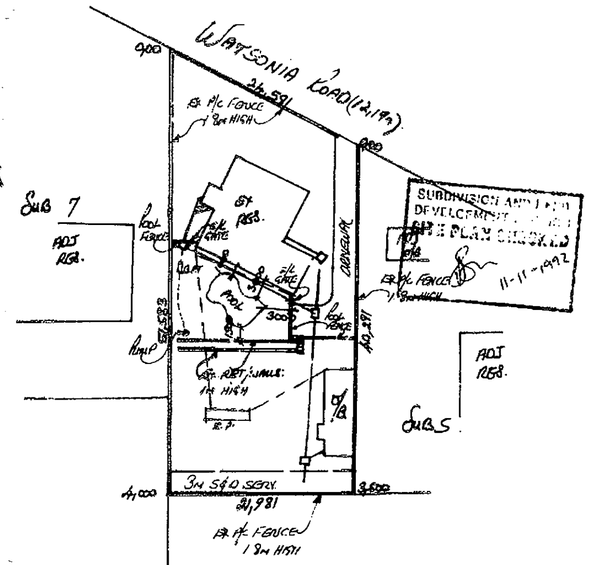

SITE PLAN 1: 500

SHEET 1/1 COPY 2

CITY OF DURBAN

PLAN NUMBER
0358/11/92/1

APPROVED SUBJECT TO FOLLOWING CONDITIONS:

~~THE POOL TO BE FENCED AS REQUIRED IN TERMS OF D4 (1,2,3) OF THE NATIONAL BUILDING REGULATIONS PRIOR TO THE POOL BEING FILLED WITH WATER.~~

APPROVED: R. A. MOORE
EXECUTIVE DIRECTOR: PHYSICAL ENVIRONMENT SERVICE UNIT
DATE 18.11.92 PER

T [illegible] SERVICES

PETER ALLEN & ASSOCIATES
GEOTECHNICAL ENGINEERS
P.O. BOX 844
NEW GERMANY 3620
TELEPHONE: 7010179

Pr. Eng. Reg. No. 920 899

Owner's signature:

COASTAL MURRAY POOLS
PO BOX 17180
CONGELLA
4013 TEL: 465 9966

PROPOSED SWIMMING POOL FOR Mr. G. MONTGOMERY
193 WATSONIA ROAD, BLUFF.

6 OF 1884 WENTWORTH
RATE NO: 2497057 000 VOL 4.

DATE: 9-11-92.

DRAWN BY: M. GOVENDER

SCALE: AS SHOWN

CHECKED BY

S27