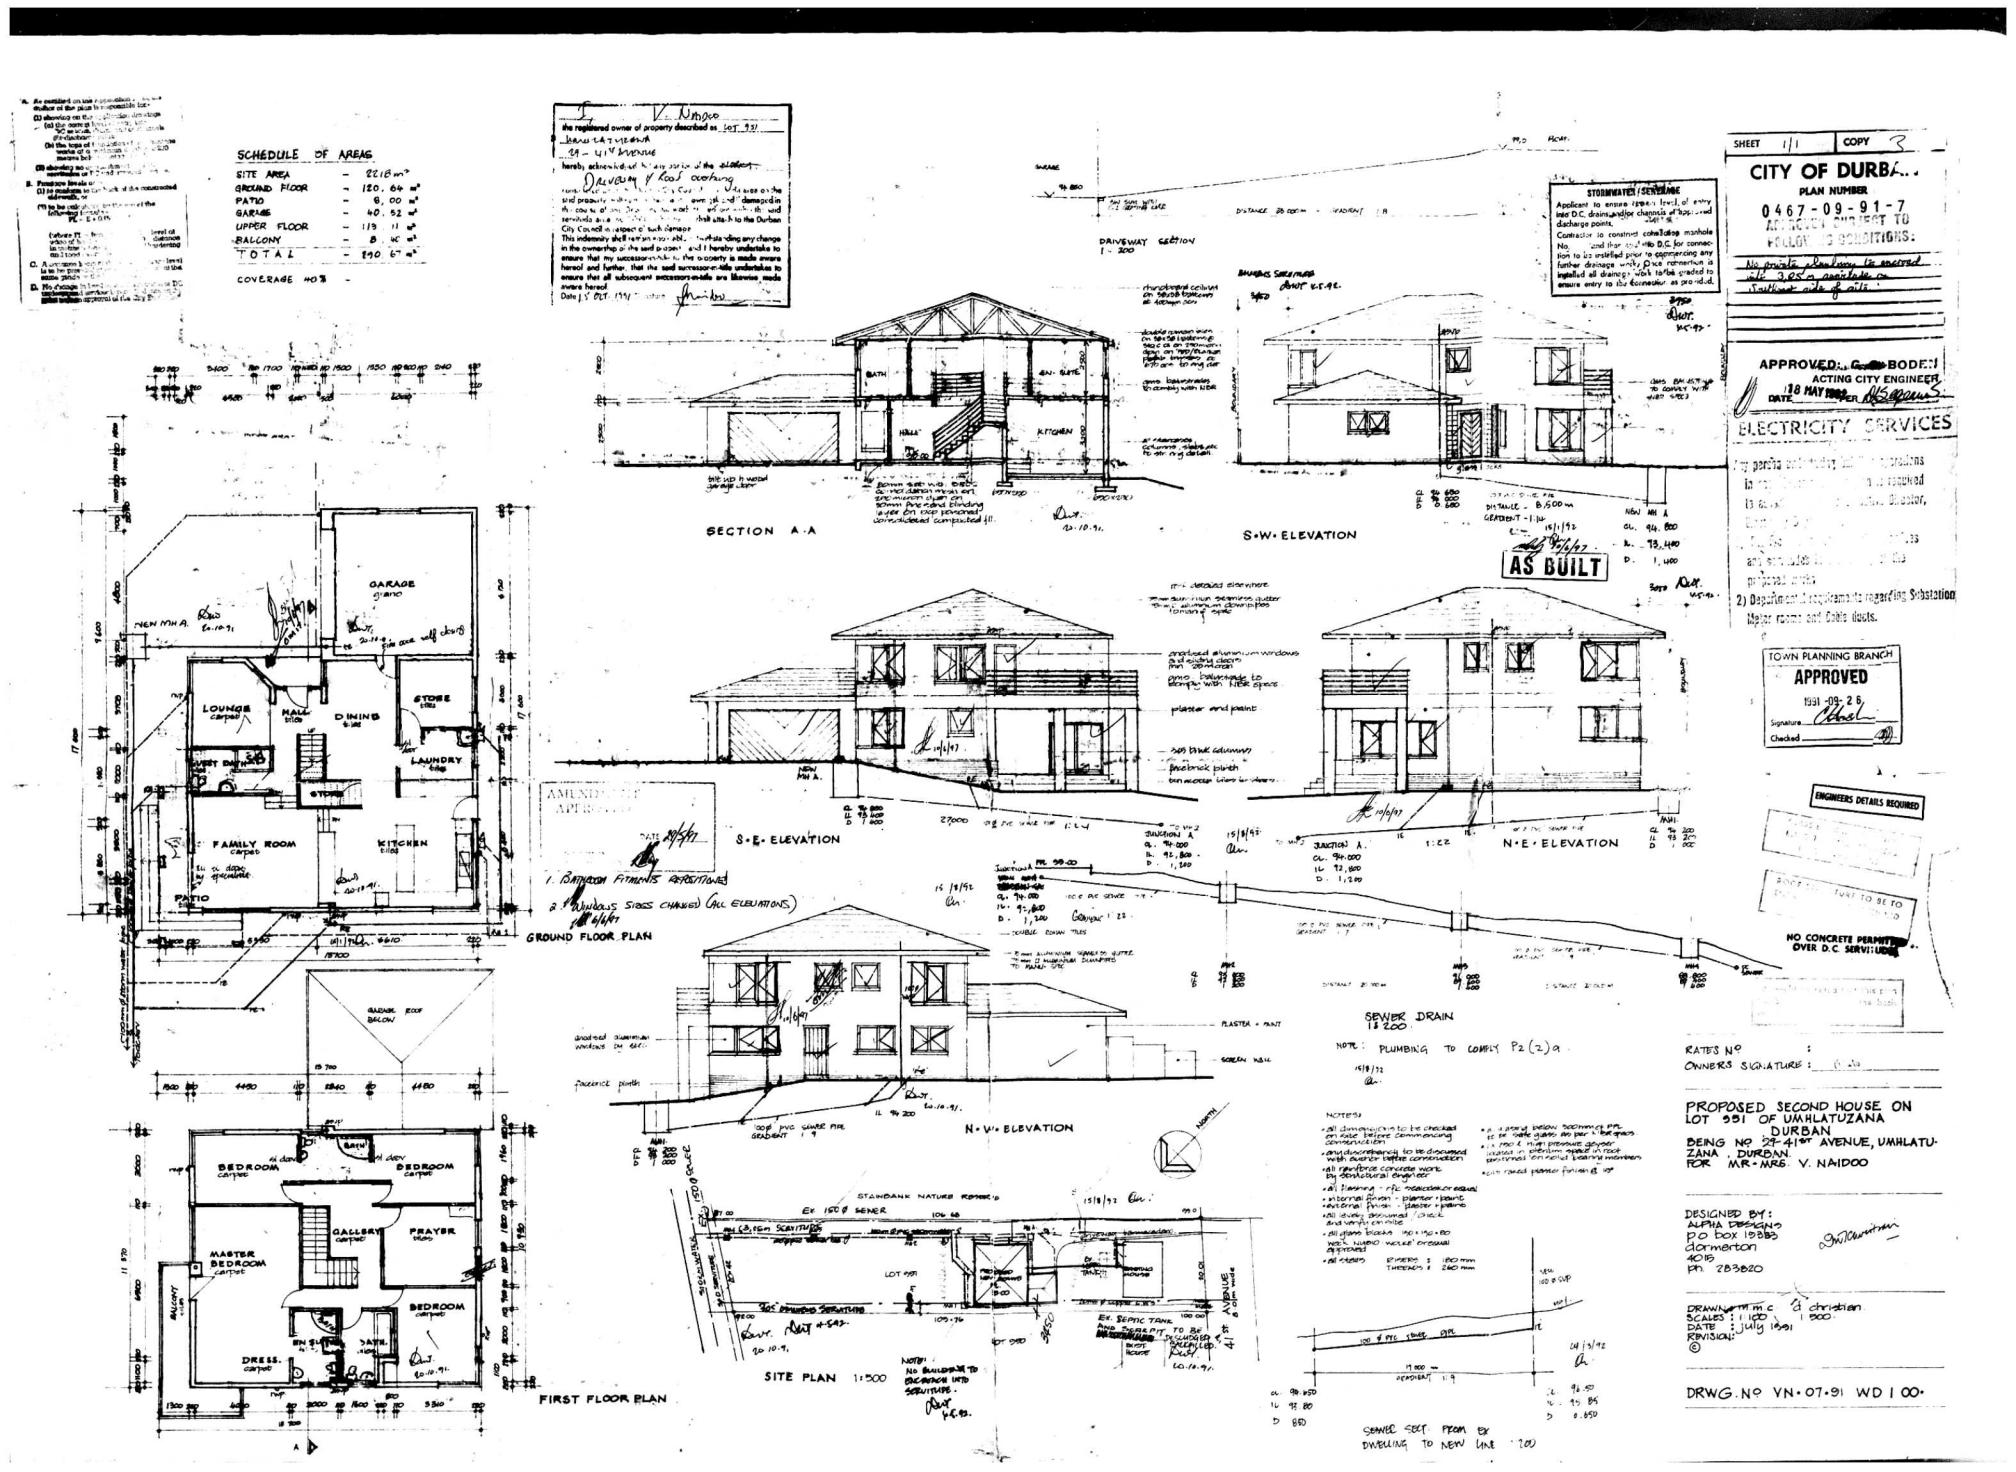
SCHEDULE OF AREAS
SITE AREA – 2218 m²
GROUND FLOOR – 120.64 m²
PATIO – 6.00 m²
GARAGE – 40.52 m²
UPPER FLOOR – 119.11 m²
BALCONY – 8.16 m²
TOTAL – 190.67 m²
COVERAGE 40%
I V. Naidoo
the registered owner of property described as LOT 991
hereby acknowledge that any portion of the abutment
CITY COUNCIL
STORMWATER / SEWERAGE
Applicant to ensure invert level of entry into D.C. drains and/or channels at proposed discharge points.
Contractor to construct concrete/brick manhole
APPROVED
ACTING CITY ENGINEER
DATE
ELECTRICITY SERVICES
SHEET 1/1
COPY
CITY OF DURBAN
PLAN NUMBER
0467-09-91-7
APPROVED SUBJECT TO THE FOLLOWING CONDITIONS:
No private driveway to encroach within 3.65 m servitude on Southeast side of site.
DRIVEWAY SECTION
1:200
SECTION A-A
S-W ELEVATION
AS BUILT
S-E ELEVATION
N-E ELEVATION
GROUND FLOOR PLAN
FIRST FLOOR PLAN
N-W ELEVATION
SITE PLAN 1:500
SEWER DRAIN
1:200
SEWER SECT. FROM EX DWELLING TO NEW LINE 1:200
TOWN PLANNING BRANCH
APPROVED
1991-09-26
ENGINEERS DETAILS REQUIRED
NO CONCRETE PERMITTED OVER D.C. SERVITUDES
RATES Nº :
OWNERS SIGNATURE :
PROPOSED SECOND HOUSE ON LOT 991 OF UMHLATUZANA DURBAN
BEING Nº 29-41ST AVENUE, UMHLATUZANA, DURBAN.
FOR MR-MRS. V. NAIDOO
DESIGNED BY:
ALPHA DESIGNS
P.O. box 19885
clarmerton
4019
Ph. 283820
DRAWN: M.C. & christian
SCALES: 1:100 & 1:500
DATE: July 1991
REVISION:
©
DRWG. Nº VN-07-91 WD 1 00-