NOTES AANTEKENINGS

44 LANCERS RD

COURTESY PLAN

SHEET 15 | COPY 1

CITY OF DURBAN

PLAN No. 0475 of 1991

P139

DETAIL B

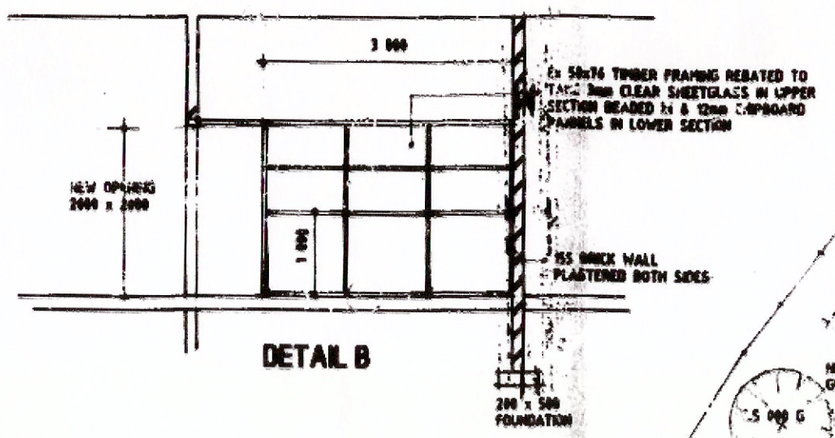

DETAIL A

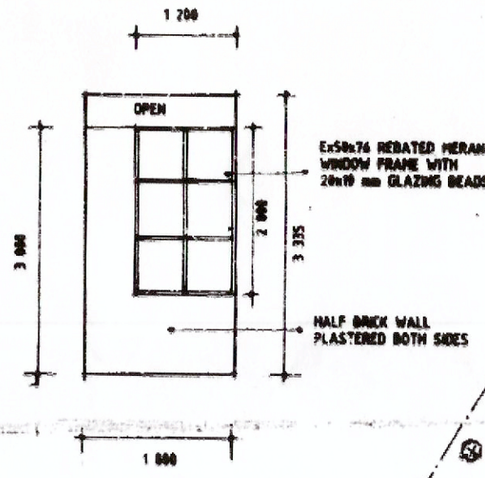

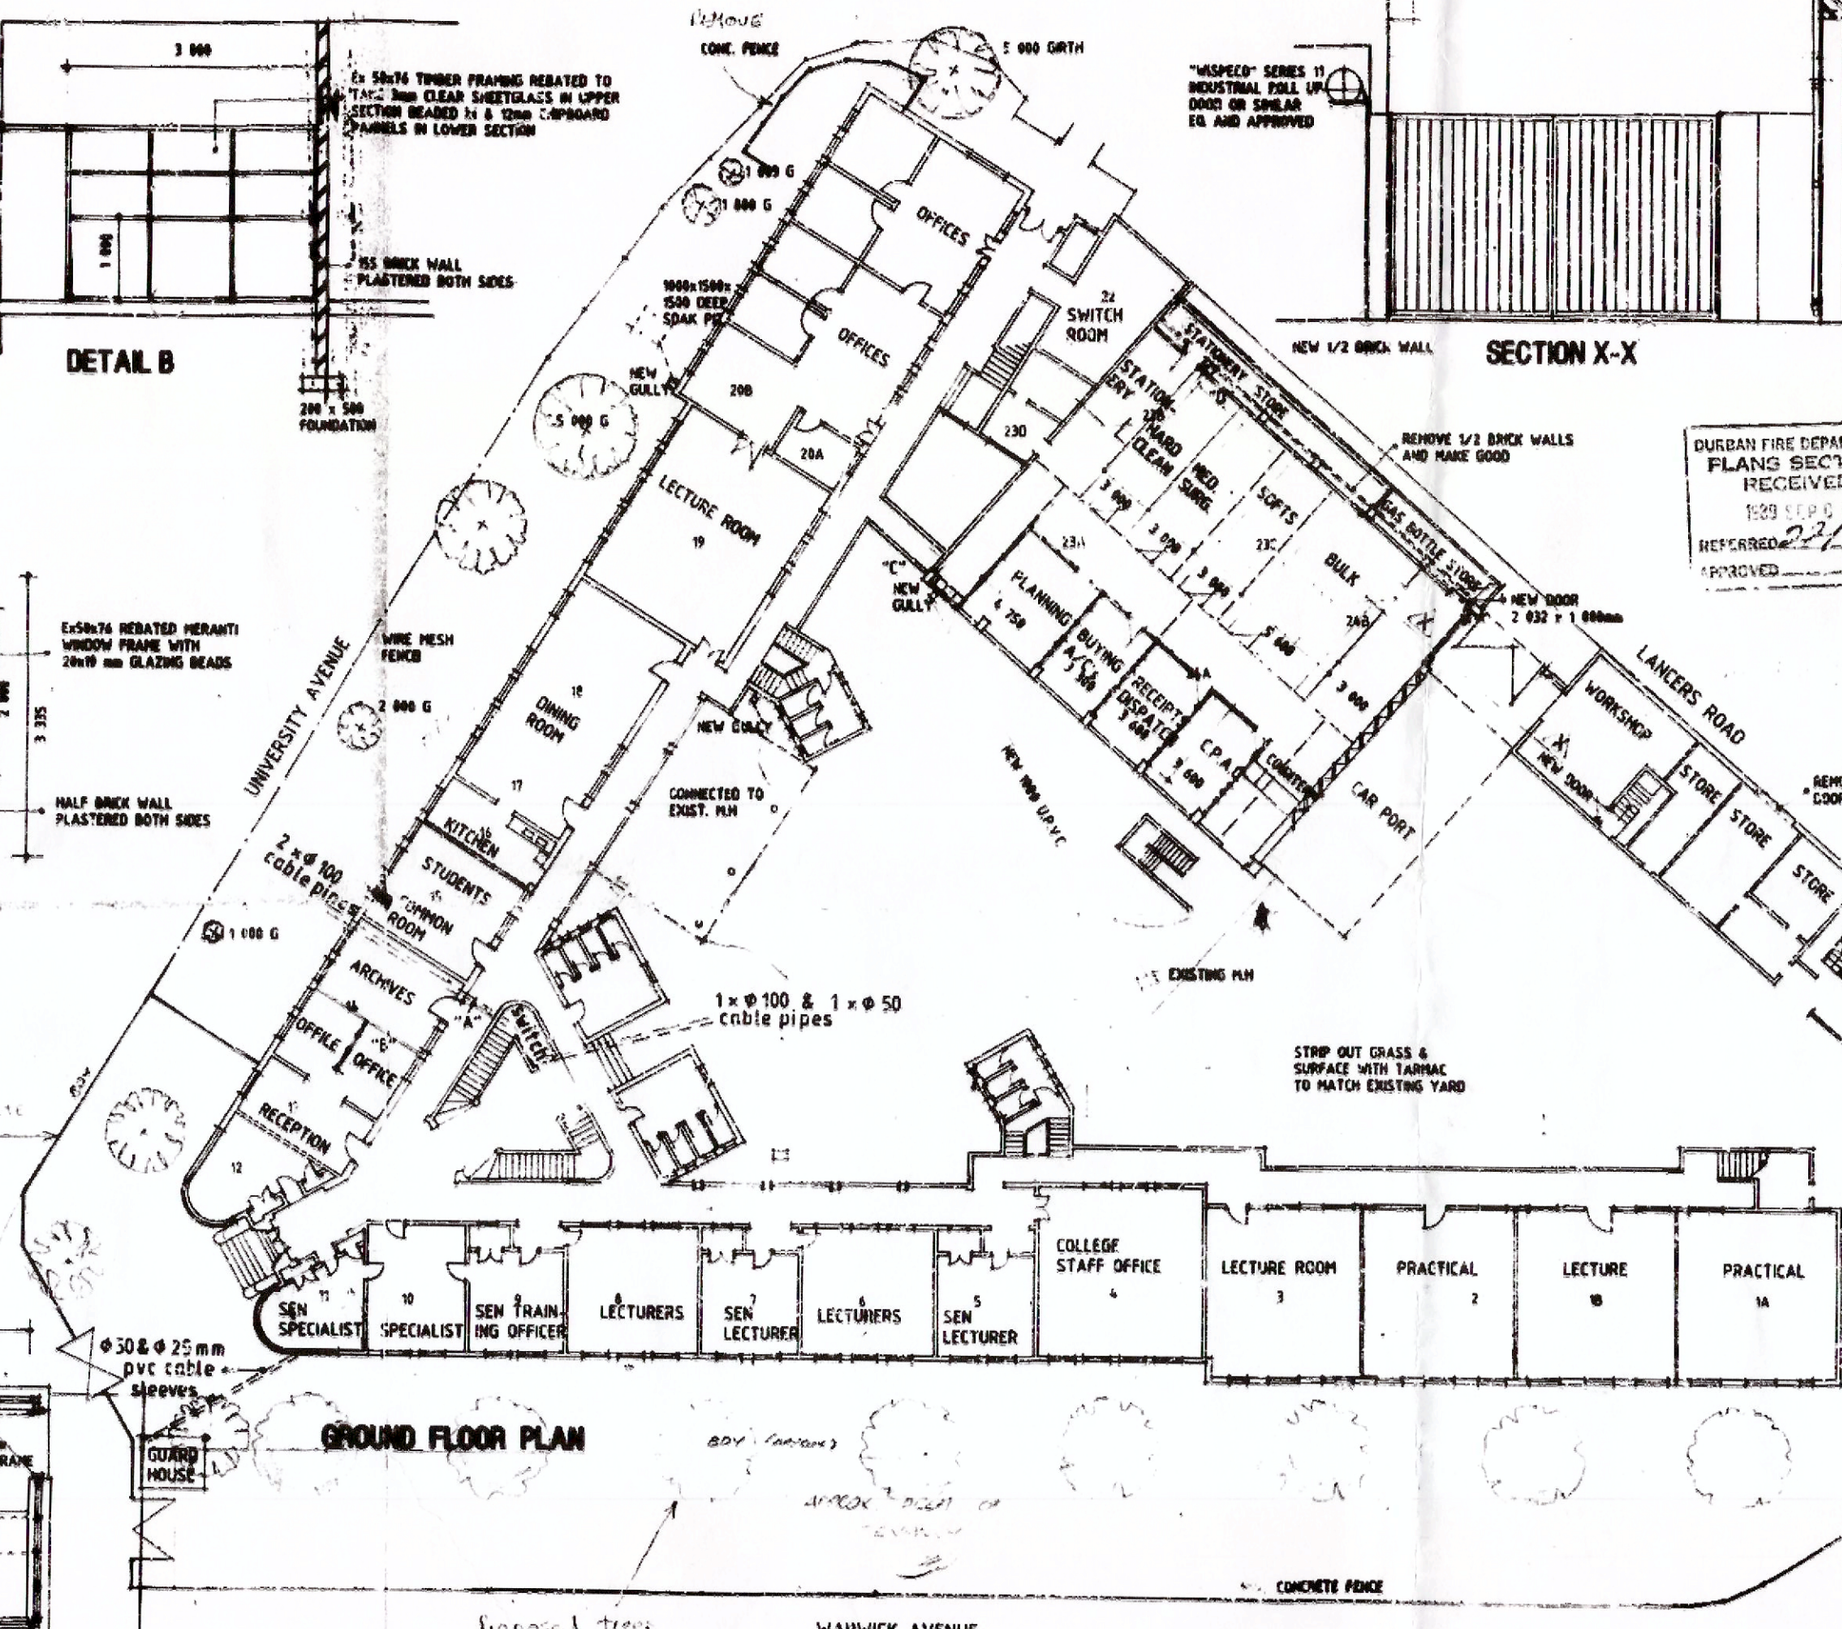

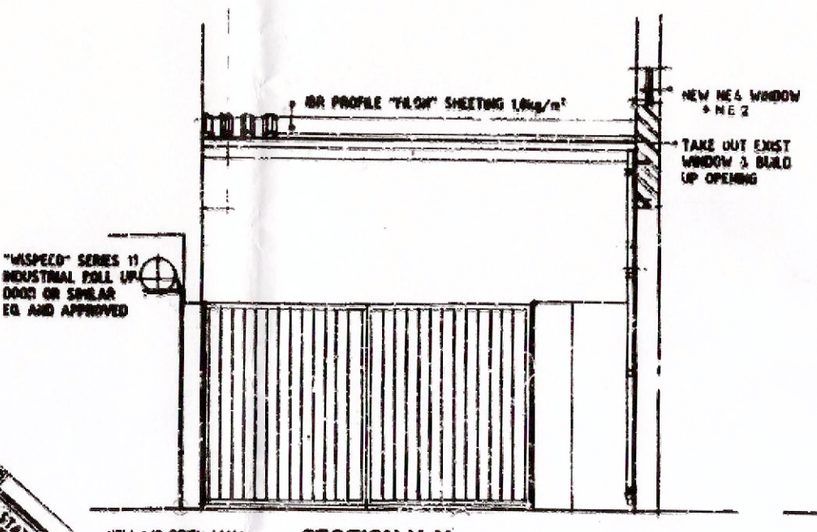

SECTION X-X

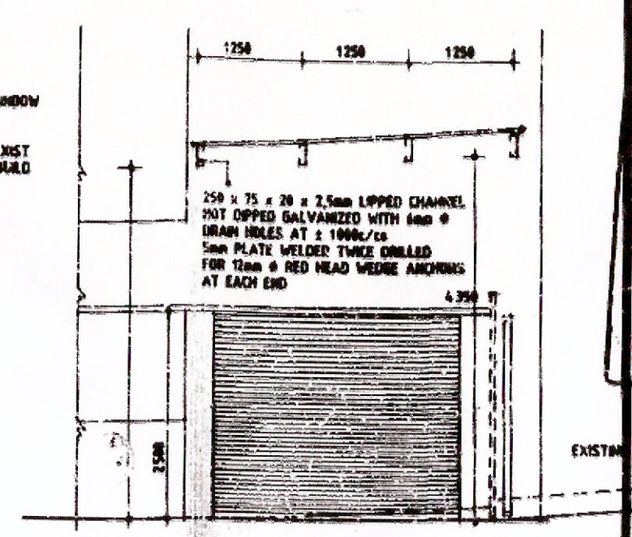

ELEVATION

DURBAN FIRE DEPARTMENT
PLANS SECTION
RECEIVED
1989 SEP
REFERRED 22/9/89
APPROVED

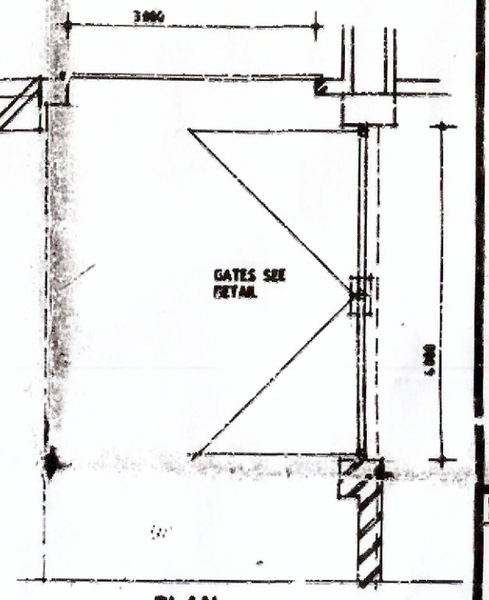

PLAN

PHASES

PHASE I ADMINISTRATION
ROOMS: GROUND FLOOR ROOMS 11-12
FIRST FLOOR ROOMS 103-121

PHASE II SUPPLIES
ROOMS: GROUND FLOOR ROOMS 23A-23C
FF FLOOR ROOMS ASSEMBLY HALL

PHASE II TECHNICAL
OUT BUILDINGS
GROUND AND 1st FLOOR

PHASE IV COLLEGE
ROOMS: GROUND FLOOR 1-14
FIRST FLOOR 101, 102-122
SECOND FLOOR 201-206, 205, 206

PHASE V CATERING AND AUXILLIARY SERVICES
ROOMS: GROUND FLOOR 15-18
19, 20A-21

PHASE VI METRO CENTRE
ROOMS: THIRD FLOOR 301

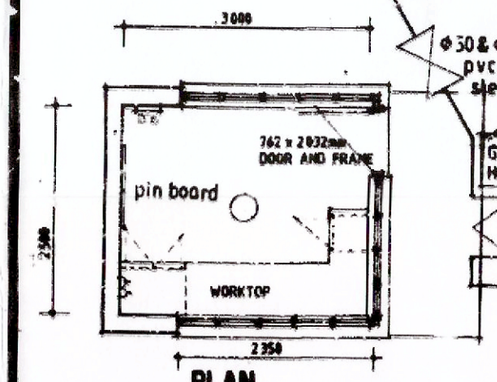

PLAN

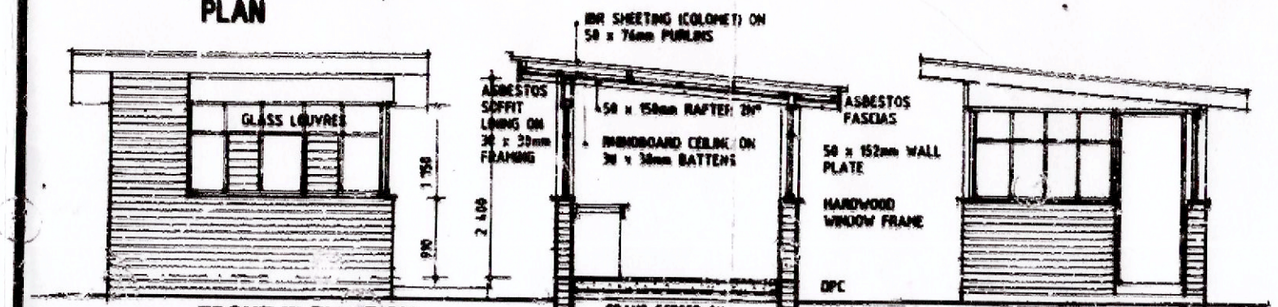

FRONT ELEVATION — SECTION — END ELEVATION

GUARD HOUSE

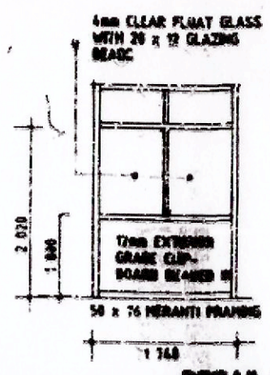

DETAIL C

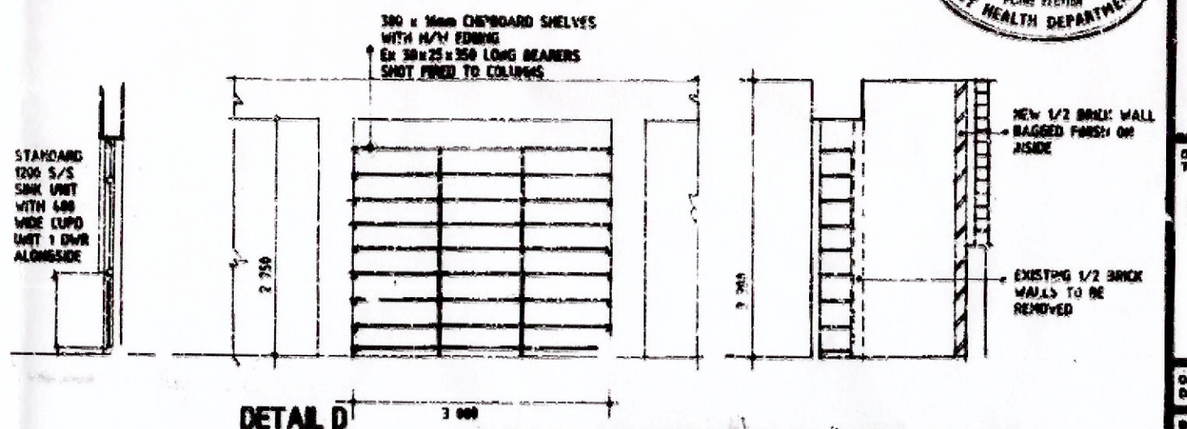

DETAIL D — TYPICAL SHELVING LAYOUT PER BAY @ 3,5

Remove wire mesh fence and plant soft landscape area

CITY Medical Officer of Health 1989 -03- 27 CITY HEALTH DEPARTMENT

	DRAWN OPGETEKEN	CHECKED NAGEMEN
ARCHITECT ARGITEK	JJ	JJ
STRUCT ENG. STRUKT ING.		
CIVIL ENG. BURGLS ING.		
ELEC. ENG. ELEK. ING.		
MECH. ENG. WERKT. ING.		

NATAL PROVINCIAL ADMINISTRATION
WORKS BRANCH
NATAL PROVINSIALE ADMINISTRASIE
TAK WERKE

DR. W.O. SERVANT.
Cert. Arch., M Arch., Ph.D., Arch. (S.A.)
M.I.A. R.I.B.A. A.S.A.I.S. A.A.Arb. Dip Soc Admin
F.S.I.M., A.S.A.I.M., M.I.Mkt.M., A.I.A.C.
DIRECTOR / DIREKTEUR

PROJECT PROJEK

OLDHAM HOUSE

DURBAN
ACCOMMODATION FOR AMBULANCE SERVICES

DRAWING TITLE TEKENINGTITEL

PLAN OF GROUND FLOOR

DATE DATUM 28-04-88 | SCALE SKAAL 1:200 1:50

DRAWING No. TEKENING No. 88 035/1

A1