STATUS QUO SECTION

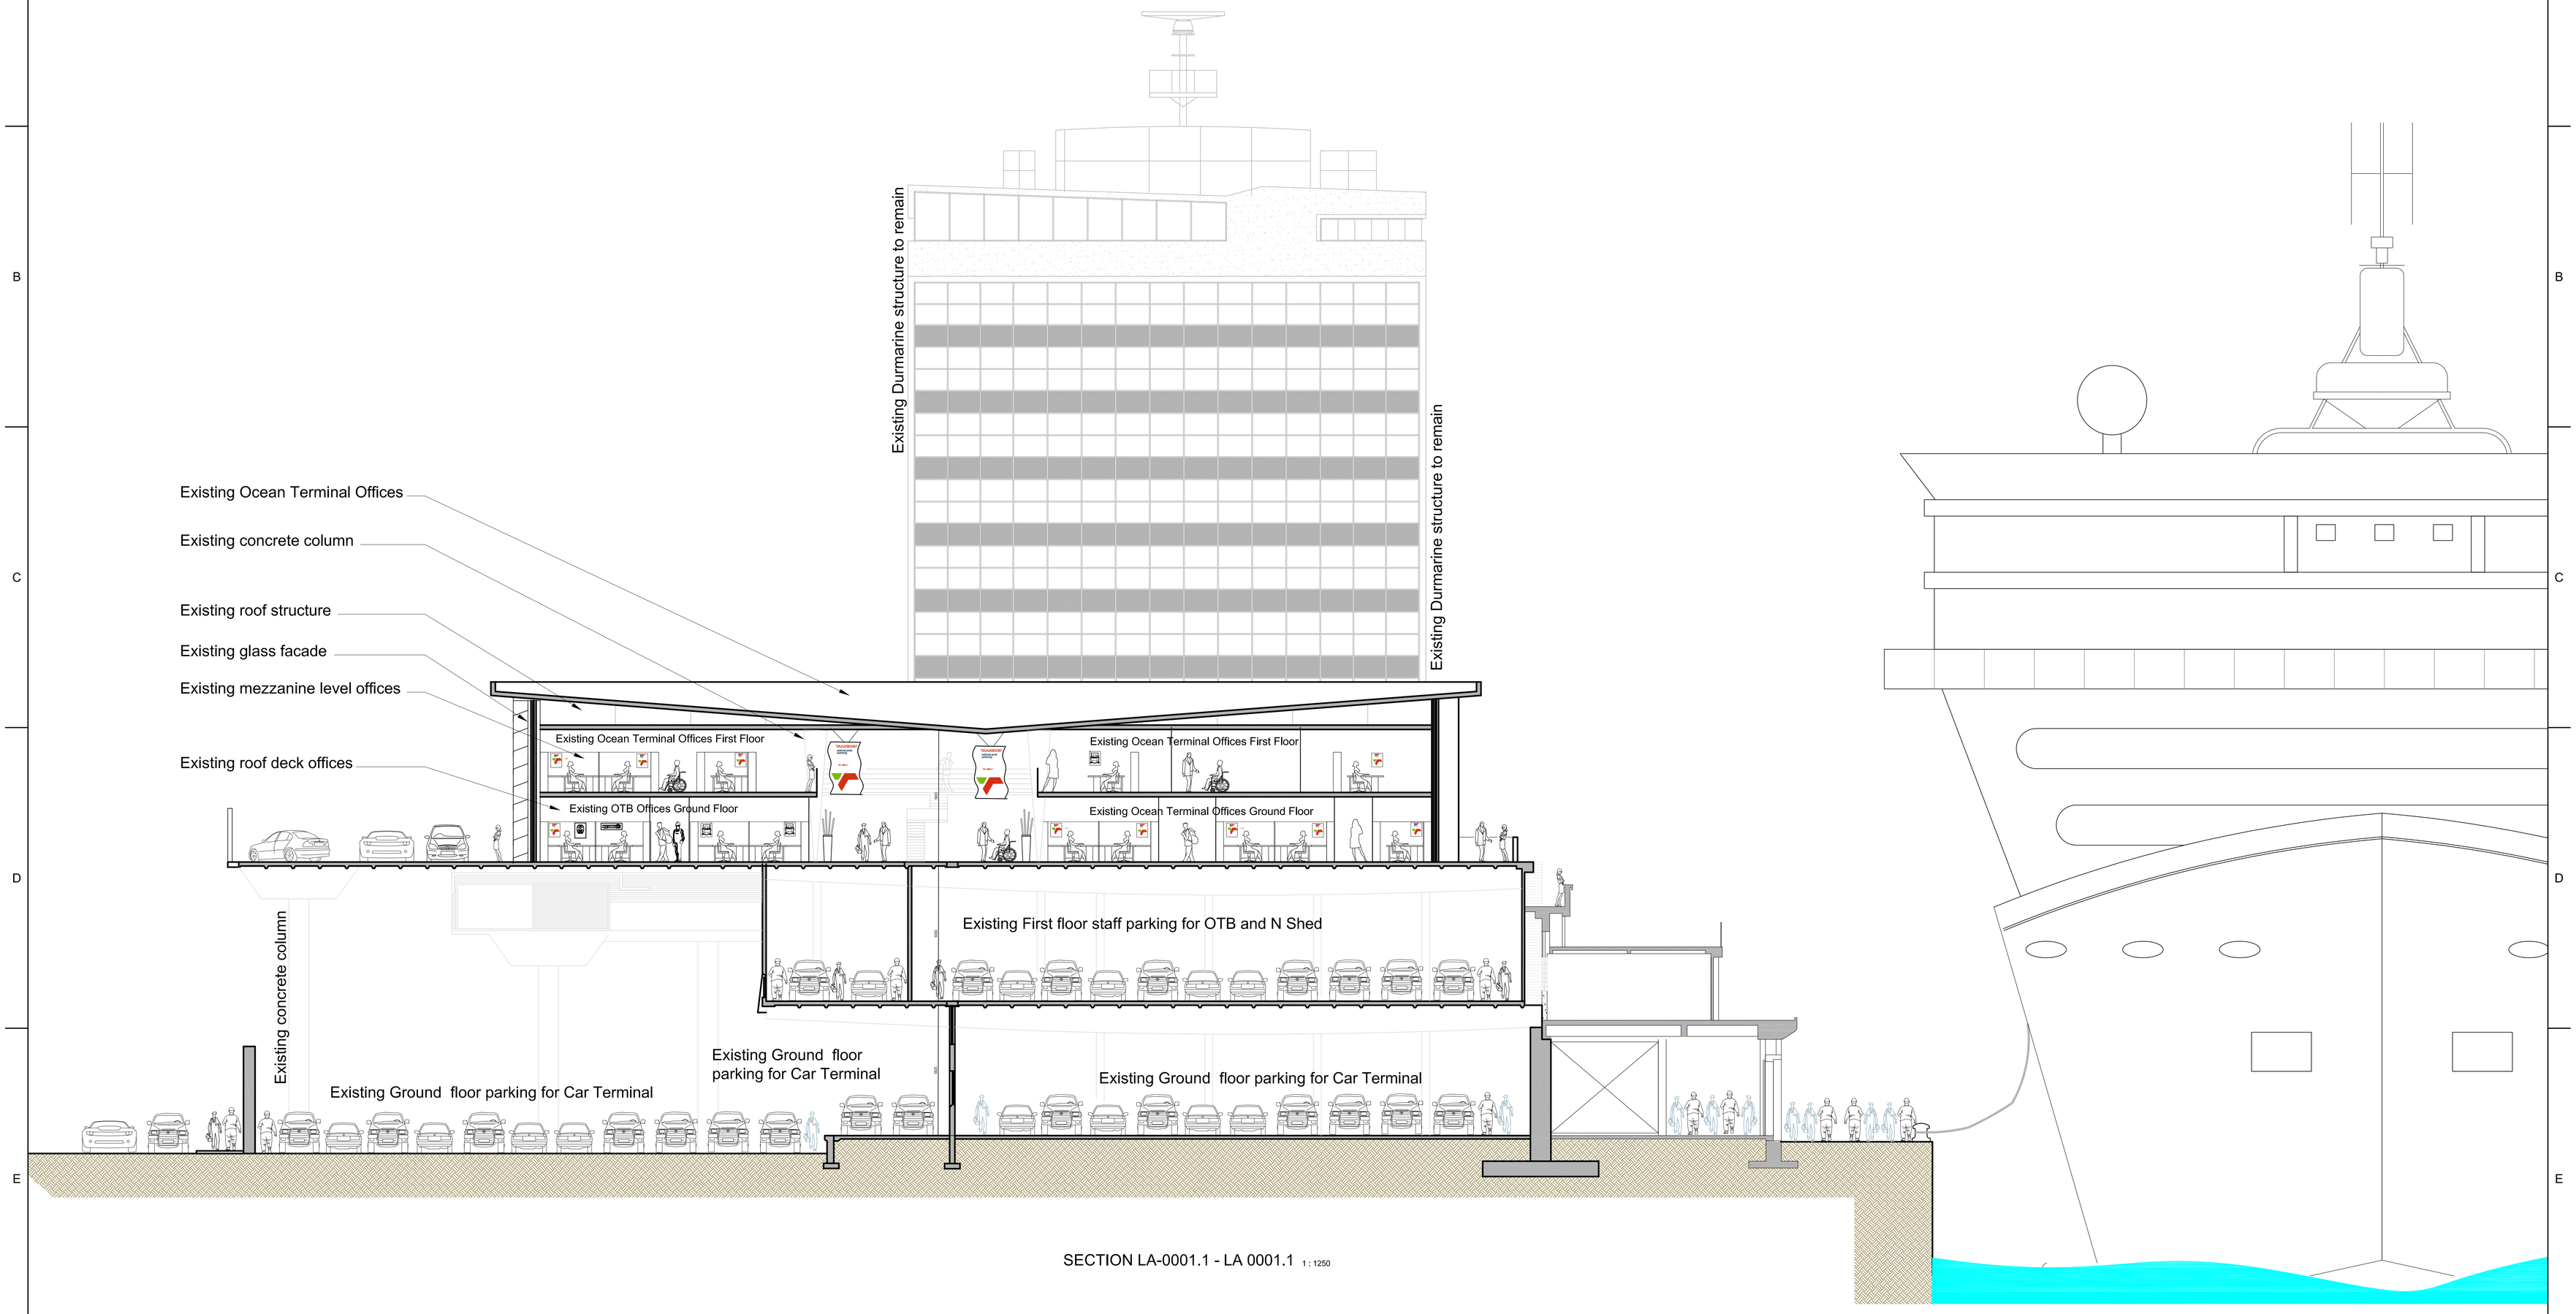

SECTION LA-0001.1 - LA 0001.1 1 : 1250

DRAWING NO.	REFERENCE
REFERENCE DRAWINGS	

NOTES

1. DO NOT SCALE DRAWING - ONLY DIMENSIONS SHOWN TO BE USED.

2. THE CONTRACTOR SHALL VERIFY ALL CONDITIONS, DIMENSIONS AND LEVELS ON THE SITE AND NOTIFY THE NEC SUPERVISOR OF ANY VARIATIONS BEFORE CONSTRUCTION.

APPLICATION FOR AMAFA APPROVAL

NO.	DESCRIPTION	BY	CHKD	APPD	DATE
0A	Issued for comment	AN	RS	AN	17/11/2020

REVISIONS

This Document including all design and information therein is Confidential Intellectual Property of Transnet.Copyright and all other rights are reserved by Transnet. This Document may only be used for its intended purpose.

CONTRACTOR / CONSULTANT			
TITLE	NAME	SIGN	DATE
OPERATING DIVISIONS			
TITLE	NAME	SIGN	DATE

TRANSNET GROUP CAPITAL			
TITLE	NAME	SIGN	DATE
DRAWN	AN		13 11 2020
CHECKED	RS		13 11 2020
DESIGNED	-		
CHECKED	-		
PR.ENG. / PR.TECH./PR. ARCH			
NAME	N.A. NAGAN		DATE
SIGNATURE			13 11 2020
REG. NUMBER	ST 0276		
SCALE :	AS SHOWN		A0

TRANSNET LTD : REG. NO. 1990/000030
237 MAHATMA GANDHI ROAD
DURBAN
P.O. BOX 31683, DURBAN
TEL: 031 361 1696
FAX: 0866 770815

TRANSNET national ports authority

PORT OF DURBAN

T JETTY

CAR TERMINAL EXPANSION
CONVERSION OF OCEAN TERMINAL BUILDING TO CAR TERMINAL ADDITIONAL PARKING
Section Existing

PROJECT NUMBER	OD	FBS	DIS	TYPE	DRAWING NO.	SHEET	REV	ID
OTBEXPN1	00	A	S	E	0001	01	0A	TD