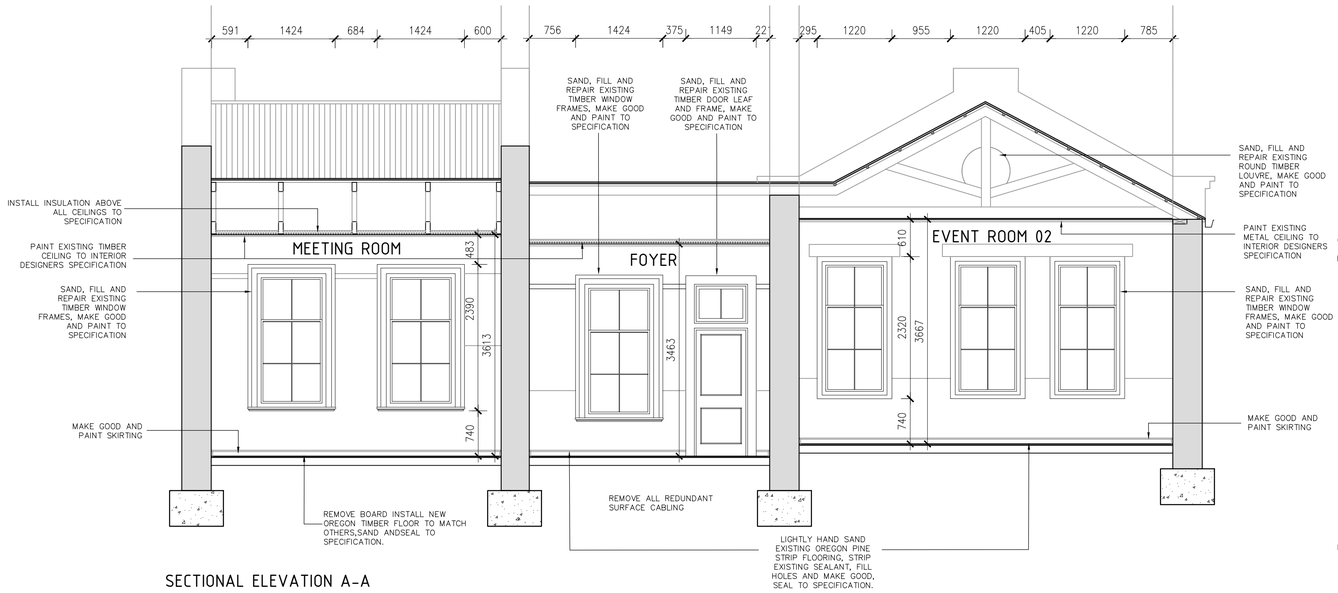

SECTIONAL ELEVATION A-A

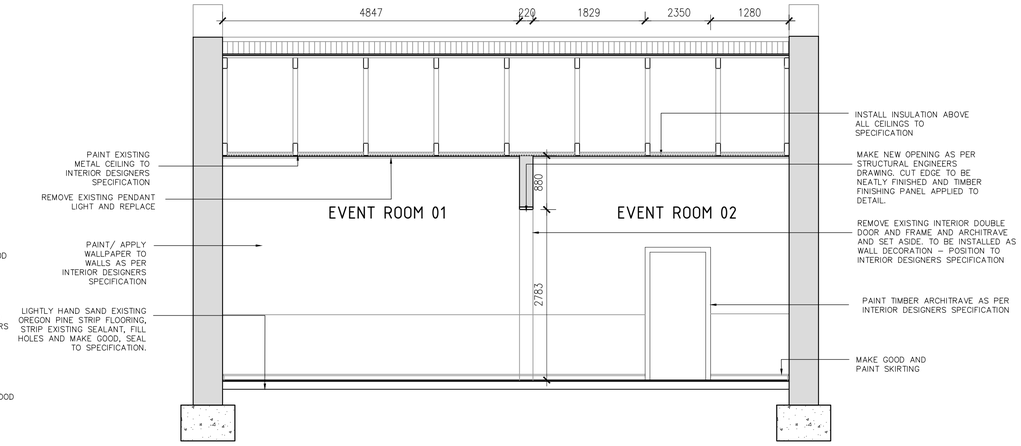

SECTIONAL ELEVATION E-E

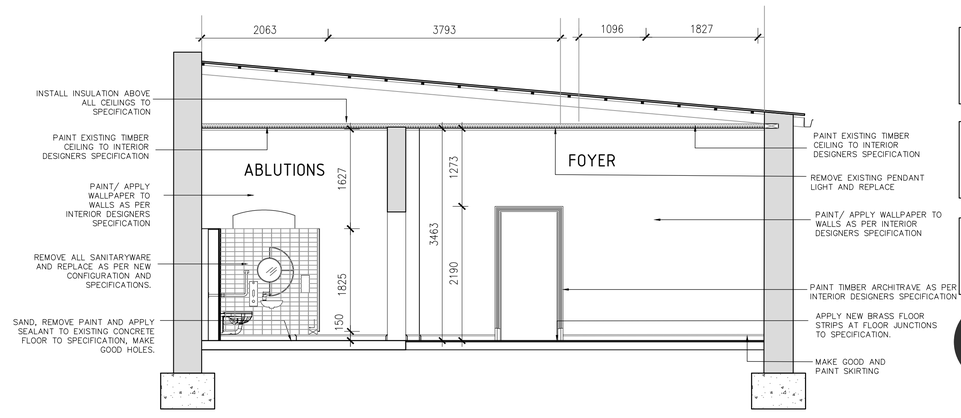

SECTIONAL ELEVATION F-F

MAKE NEW OPENING AS PER STRUCTURAL ENGINEERS DRAWING. CORRECT FLOOR LEVELS AND INSERT GLASS PANEL WITH TRIM TO FLOOR AREA WHERE WALL WAS REMOVED

REMOVE EXISTING INTERIOR DOUBLE DOOR AND FRAME AND ARCHITRAVE AND SET ASIDE (STORAGE)

REMOVE ALL SANITARYWARE AND REPLACE AS PER NEW CONFIGURATION AND SPECIFICATIONS.

MAKE NEW OPENING AS PER STRUCTURAL ENGINEERS DRAWING. CUT EDGE TO BE NEATLY FINISHED

NEW FITTINGS TO CONNECT TO EXISTING SOIL PIPE.

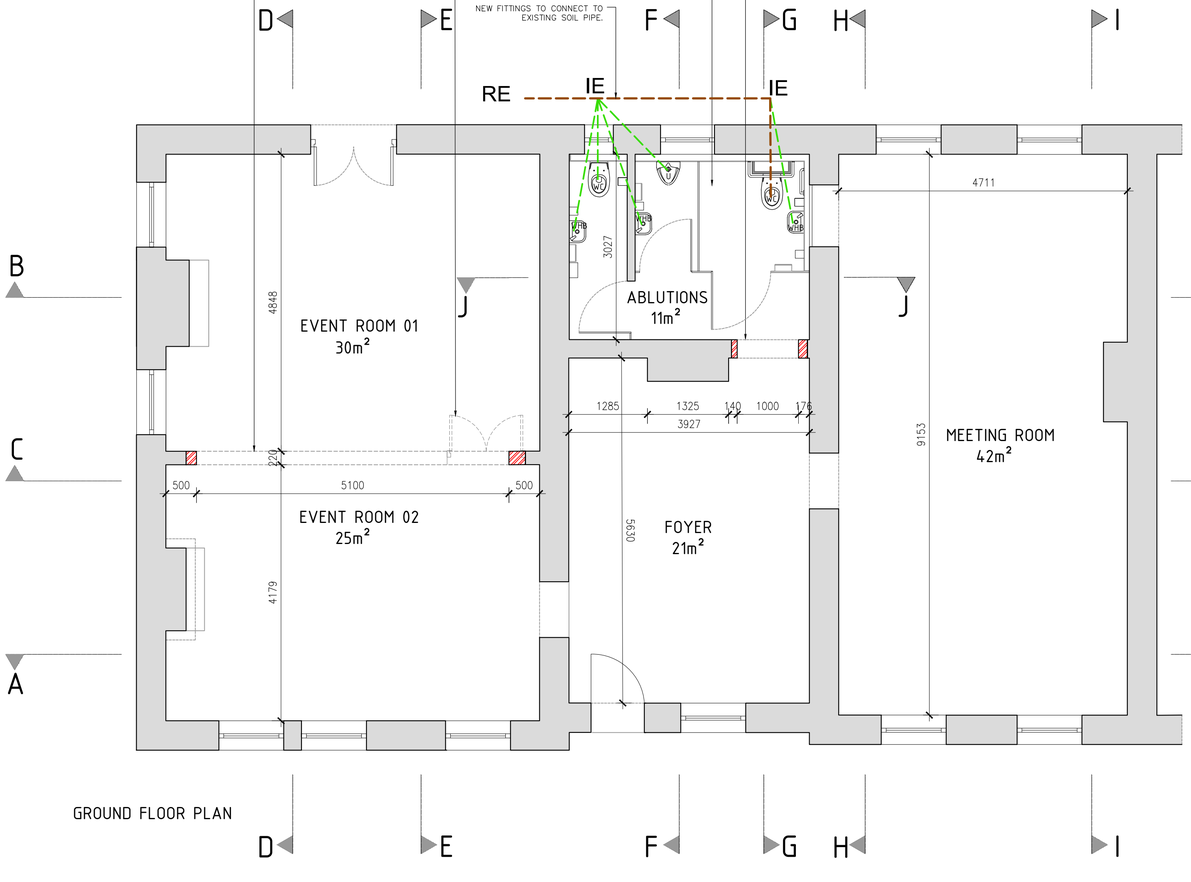

GROUND FLOOR PLAN

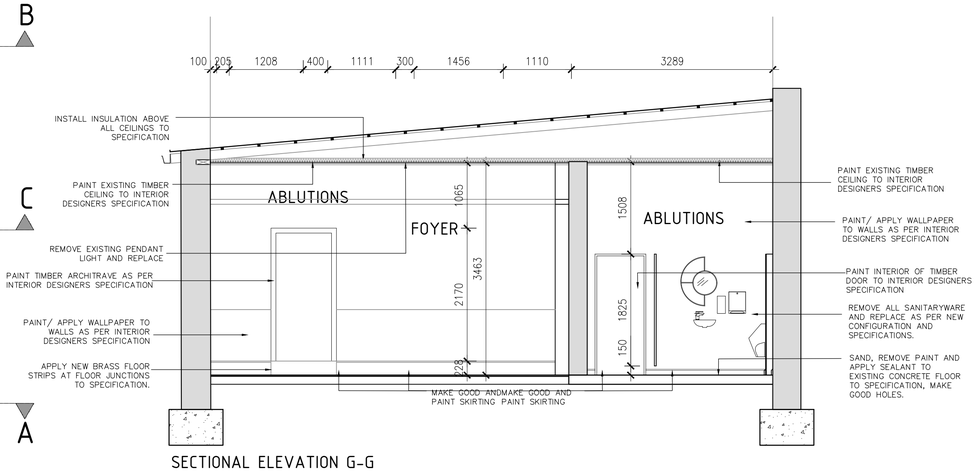

SECTIONAL ELEVATION G-G

CLIENT NAME.....

SIGNATURE.....

DATE.....

ARCHITECT NAME..... NABEEL ESSA (SACAP 6799)

SIGNATURE.....

DATE..... 03/02/2021

ENGINEER NAME.....

SIGNATURE.....

DATE.....

OFFICE 24|7 ARCHITECTURE

072 338 7553 | 011 268 2297
2nd Floor - 26 Baker Street, Rosebank, 2196, Johannesburg
P.O. Box 1541, Houghton, 2041
nabeel@nabeelessa.com | www.office24-7.co.za

DESIGN	REVISION NUMBER	DATE OF ISSUE	"CLOUDING" TO BE USED TO INDICATE REVISION AND/OR AREAS ON HOLD.

Project Title:
Constitution Hill, Old Fort Events Venue
11 Kotze Street
Braamfontein RE/69/53 -IR

Drawing Title:
AS-BUILT
Plan and Sections

Date:	Drawn:	Checked:	Scale:
03.06.2021	VS	NE	1:50

Project No:	Drawing No:	Revision:
2003	A101	

CAD File: