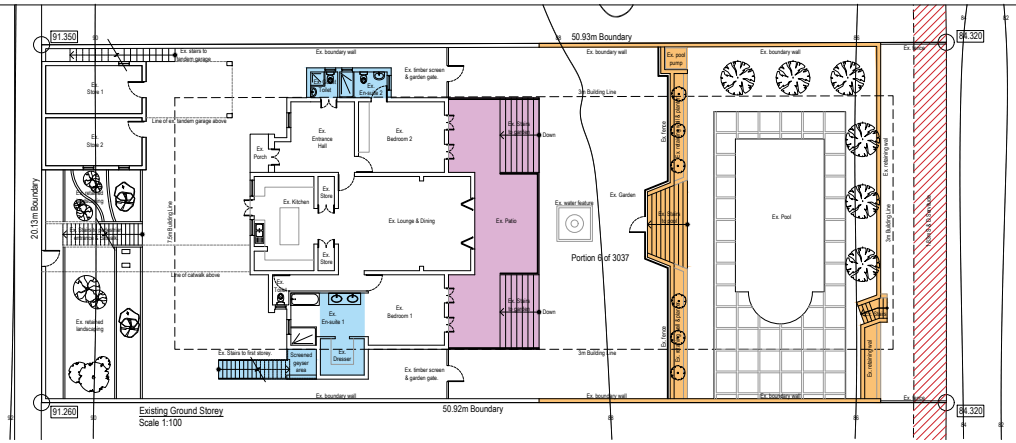
91.350
91.260
84.320
50.93m Boundary
50.92m Boundary
20.13m Boundary
Ex. boundary wall
Ex. stairs to tandem garage
Ex. Store 1
Ex. Store 2
Line of ex. tandem garage above
Ex. Porch
Ex. Entrance Hall
Ex. Bedroom 2
Ex. timber screen & garden gate.
Ex. Kitchen
Ex. Lounge & Dining
Ex. Patio
Ex. Pool
Ex. Garden
Ex. water feature
Portion 6 of 3037
Ex. Bedroom 1
Ex. En-suite 1
Ex. Dresser
Line of catwalk above
Ex. Stairs to first storey.
Screened geyser area
Ex. retained landscaping
3m Building Line
7.5m Building Line
Ex. force
Ex. reservoir wall
Ex. Stairs to Garden
Down
Ex. Stairs to Lounge
Ex. Stairs to Pool
Ex. Stairs to Pool Deck