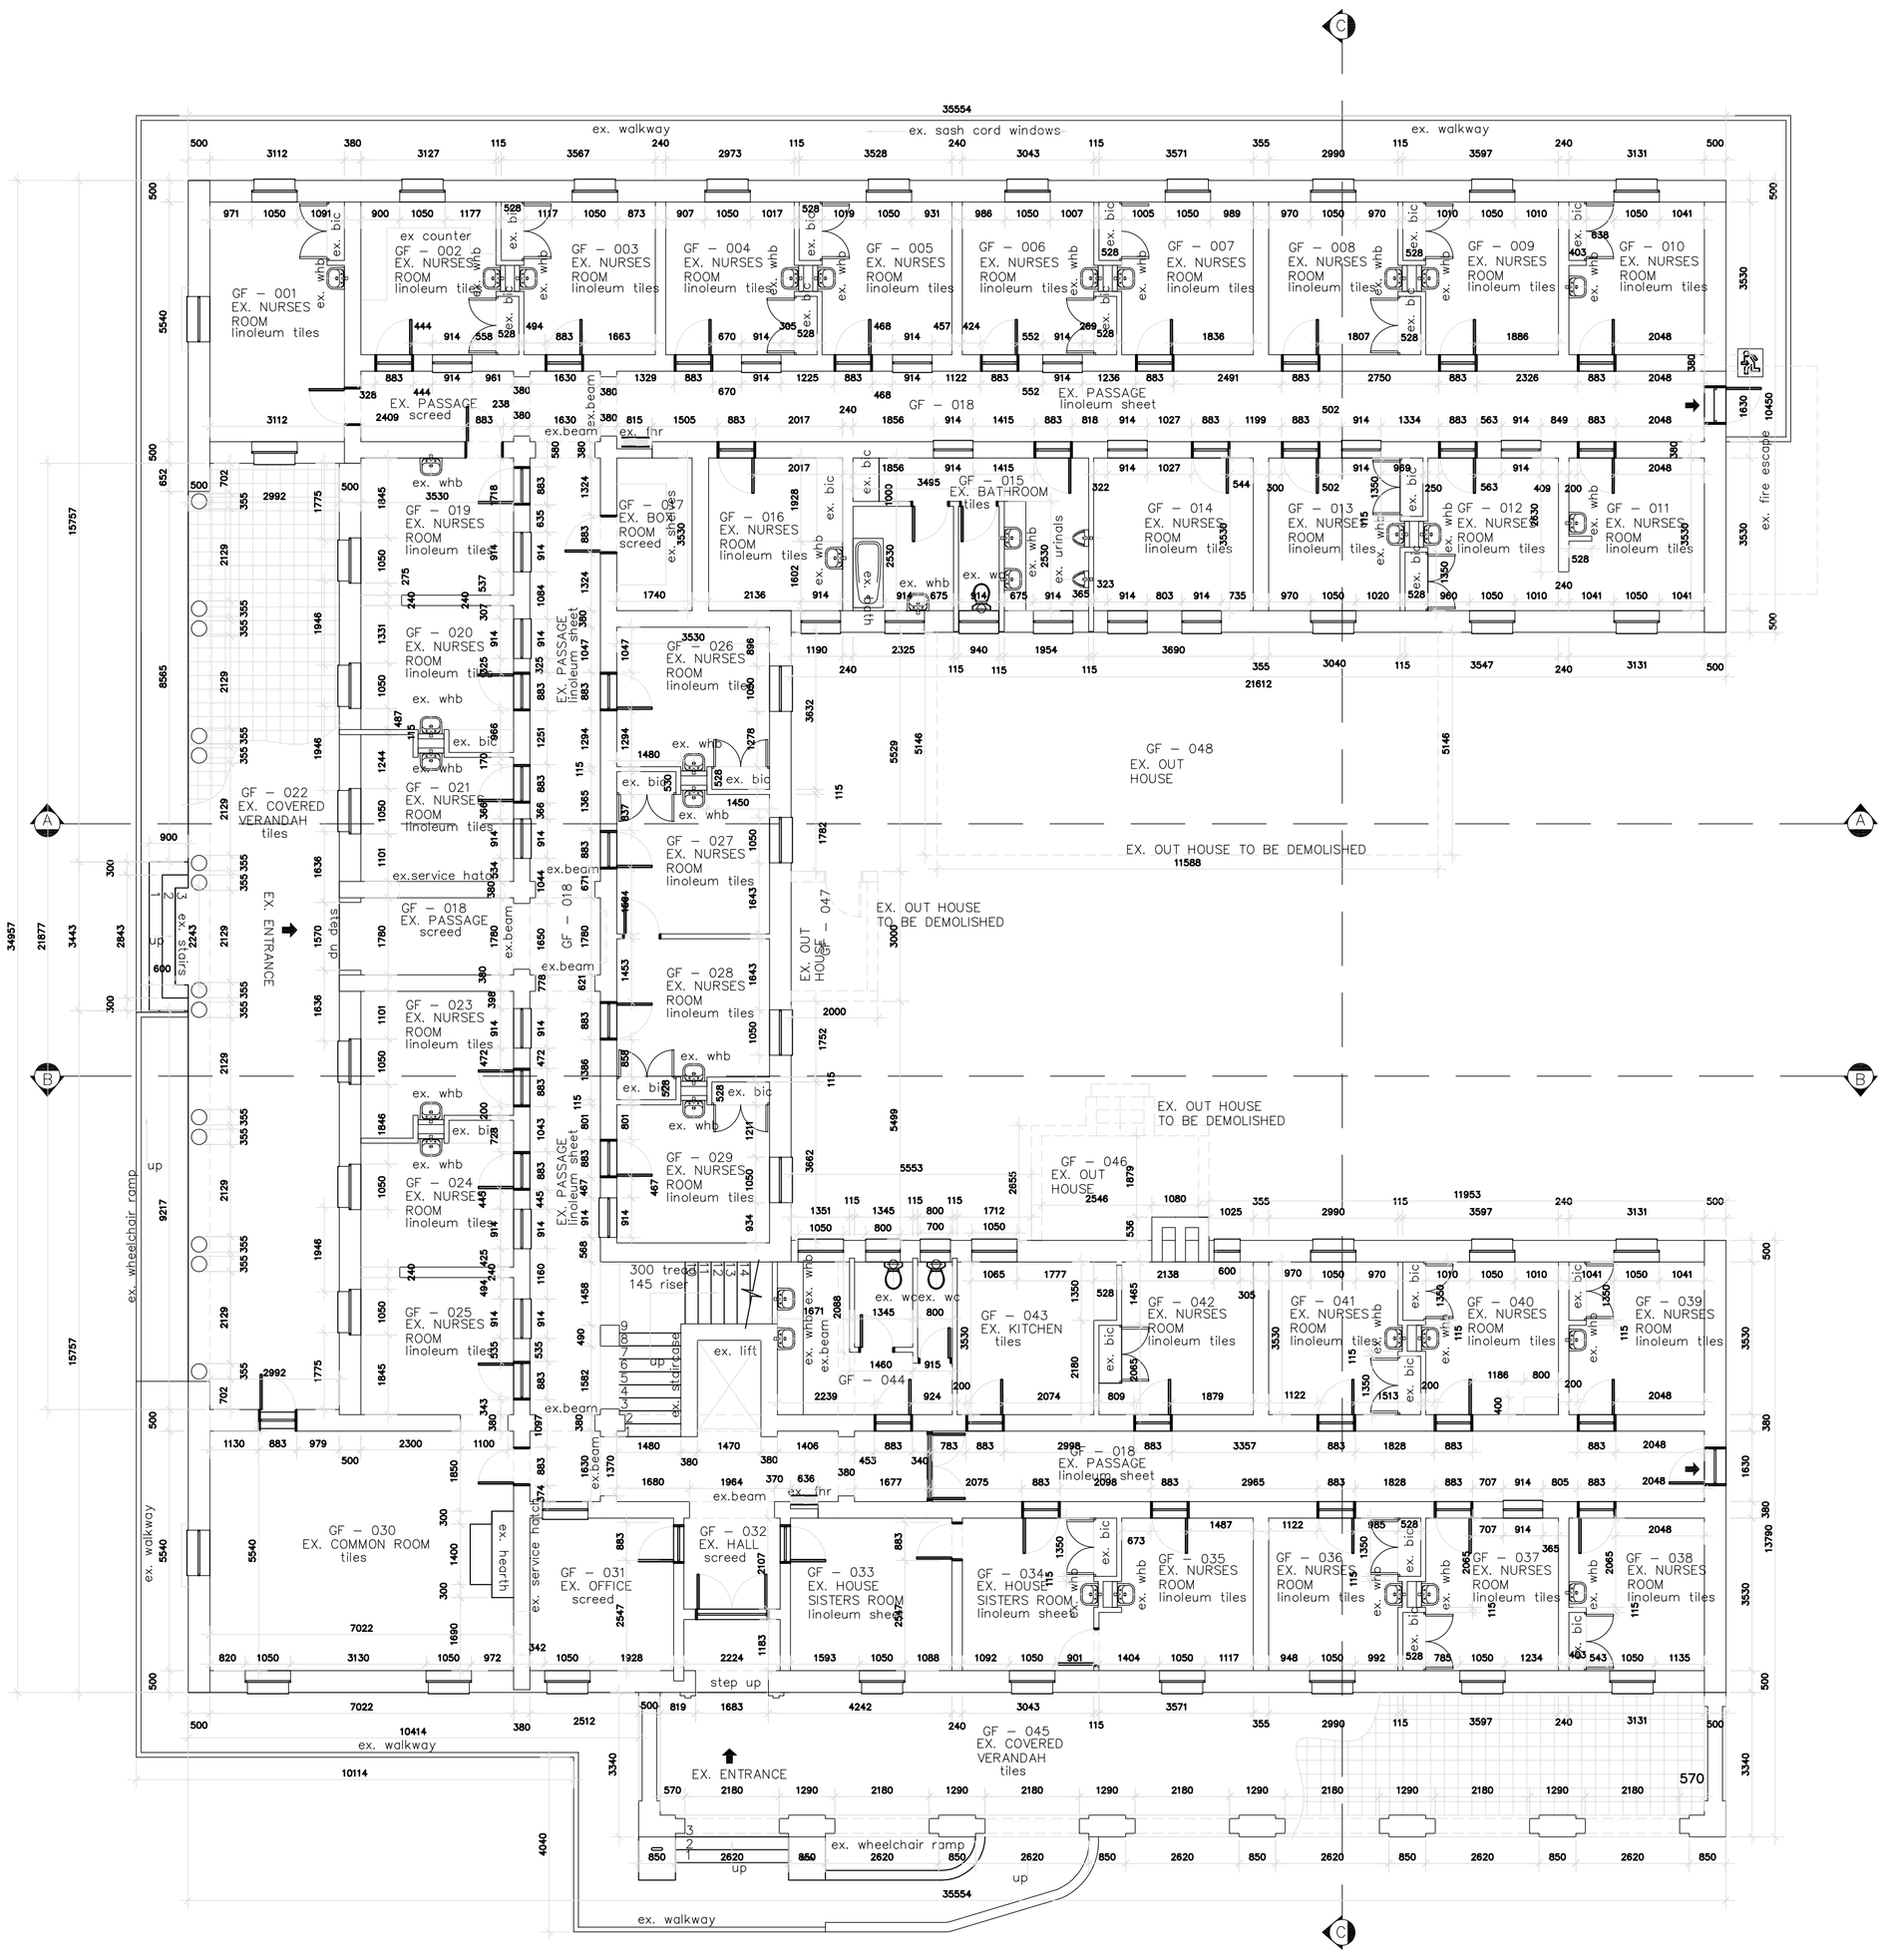

ground floor

area = 858 + 68 =926sqm

Emmett : Emmett
ARCHITECTS
LILIAN NGOYI ROAD (Windermere Rd) , DURBAN 4001
TEL. 2022907, FAX 2022908, E-MAIL.-emmettarch@inkom.co.za

OWNER/CLIENT: _____

OWNER/CLIENT SIGNATURE: _____

ARCHITECTS SIGNATURE: _____

ARCH. COUNCIL No: _____ DATE: _____

ruben reddy architects
Suite 1801, 18th Floor, 303 Pixley kaSeme Street, Durban, South Africa
T/+27 31 301 6122 | F +27 31 3016548
info@rubenreddyarch.co.za | www.rubenreddyarch.co.za

Project Title:

KZN CHILDRENS HOSPITAL
EXISTING BUILDINGS

Date: 07 AUGUST 2013	Scales:
Drawn: A.E.R./J.E./D.P.	1:100

Drawing Description:

AS BUILT DRAWINGS
NURSES HOME
GROUND FLOOR PLAN

ISSUED FOR TENDER: — ISSUED FOR CONSTRUCTION: — DATE ISSUE: _____

Job No.	Drawing No.	Rev. No.
2009_136	EX_NH_1001	01