AS BUILT PLANS OTB

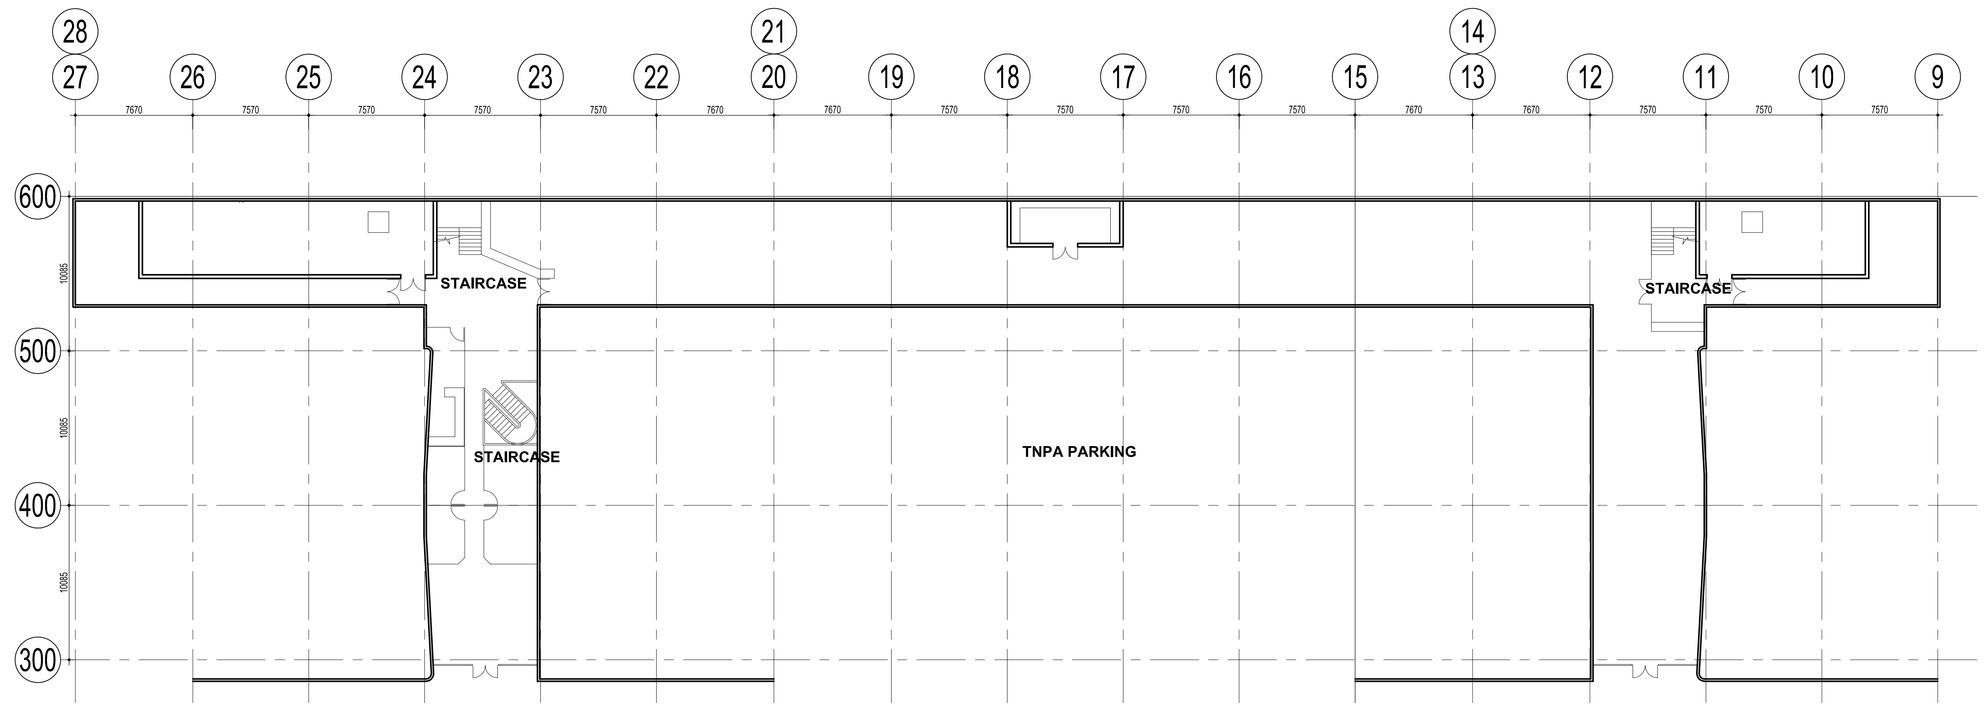

LOWER GROUND FLOOR PLAN
SCALE 1 : 200

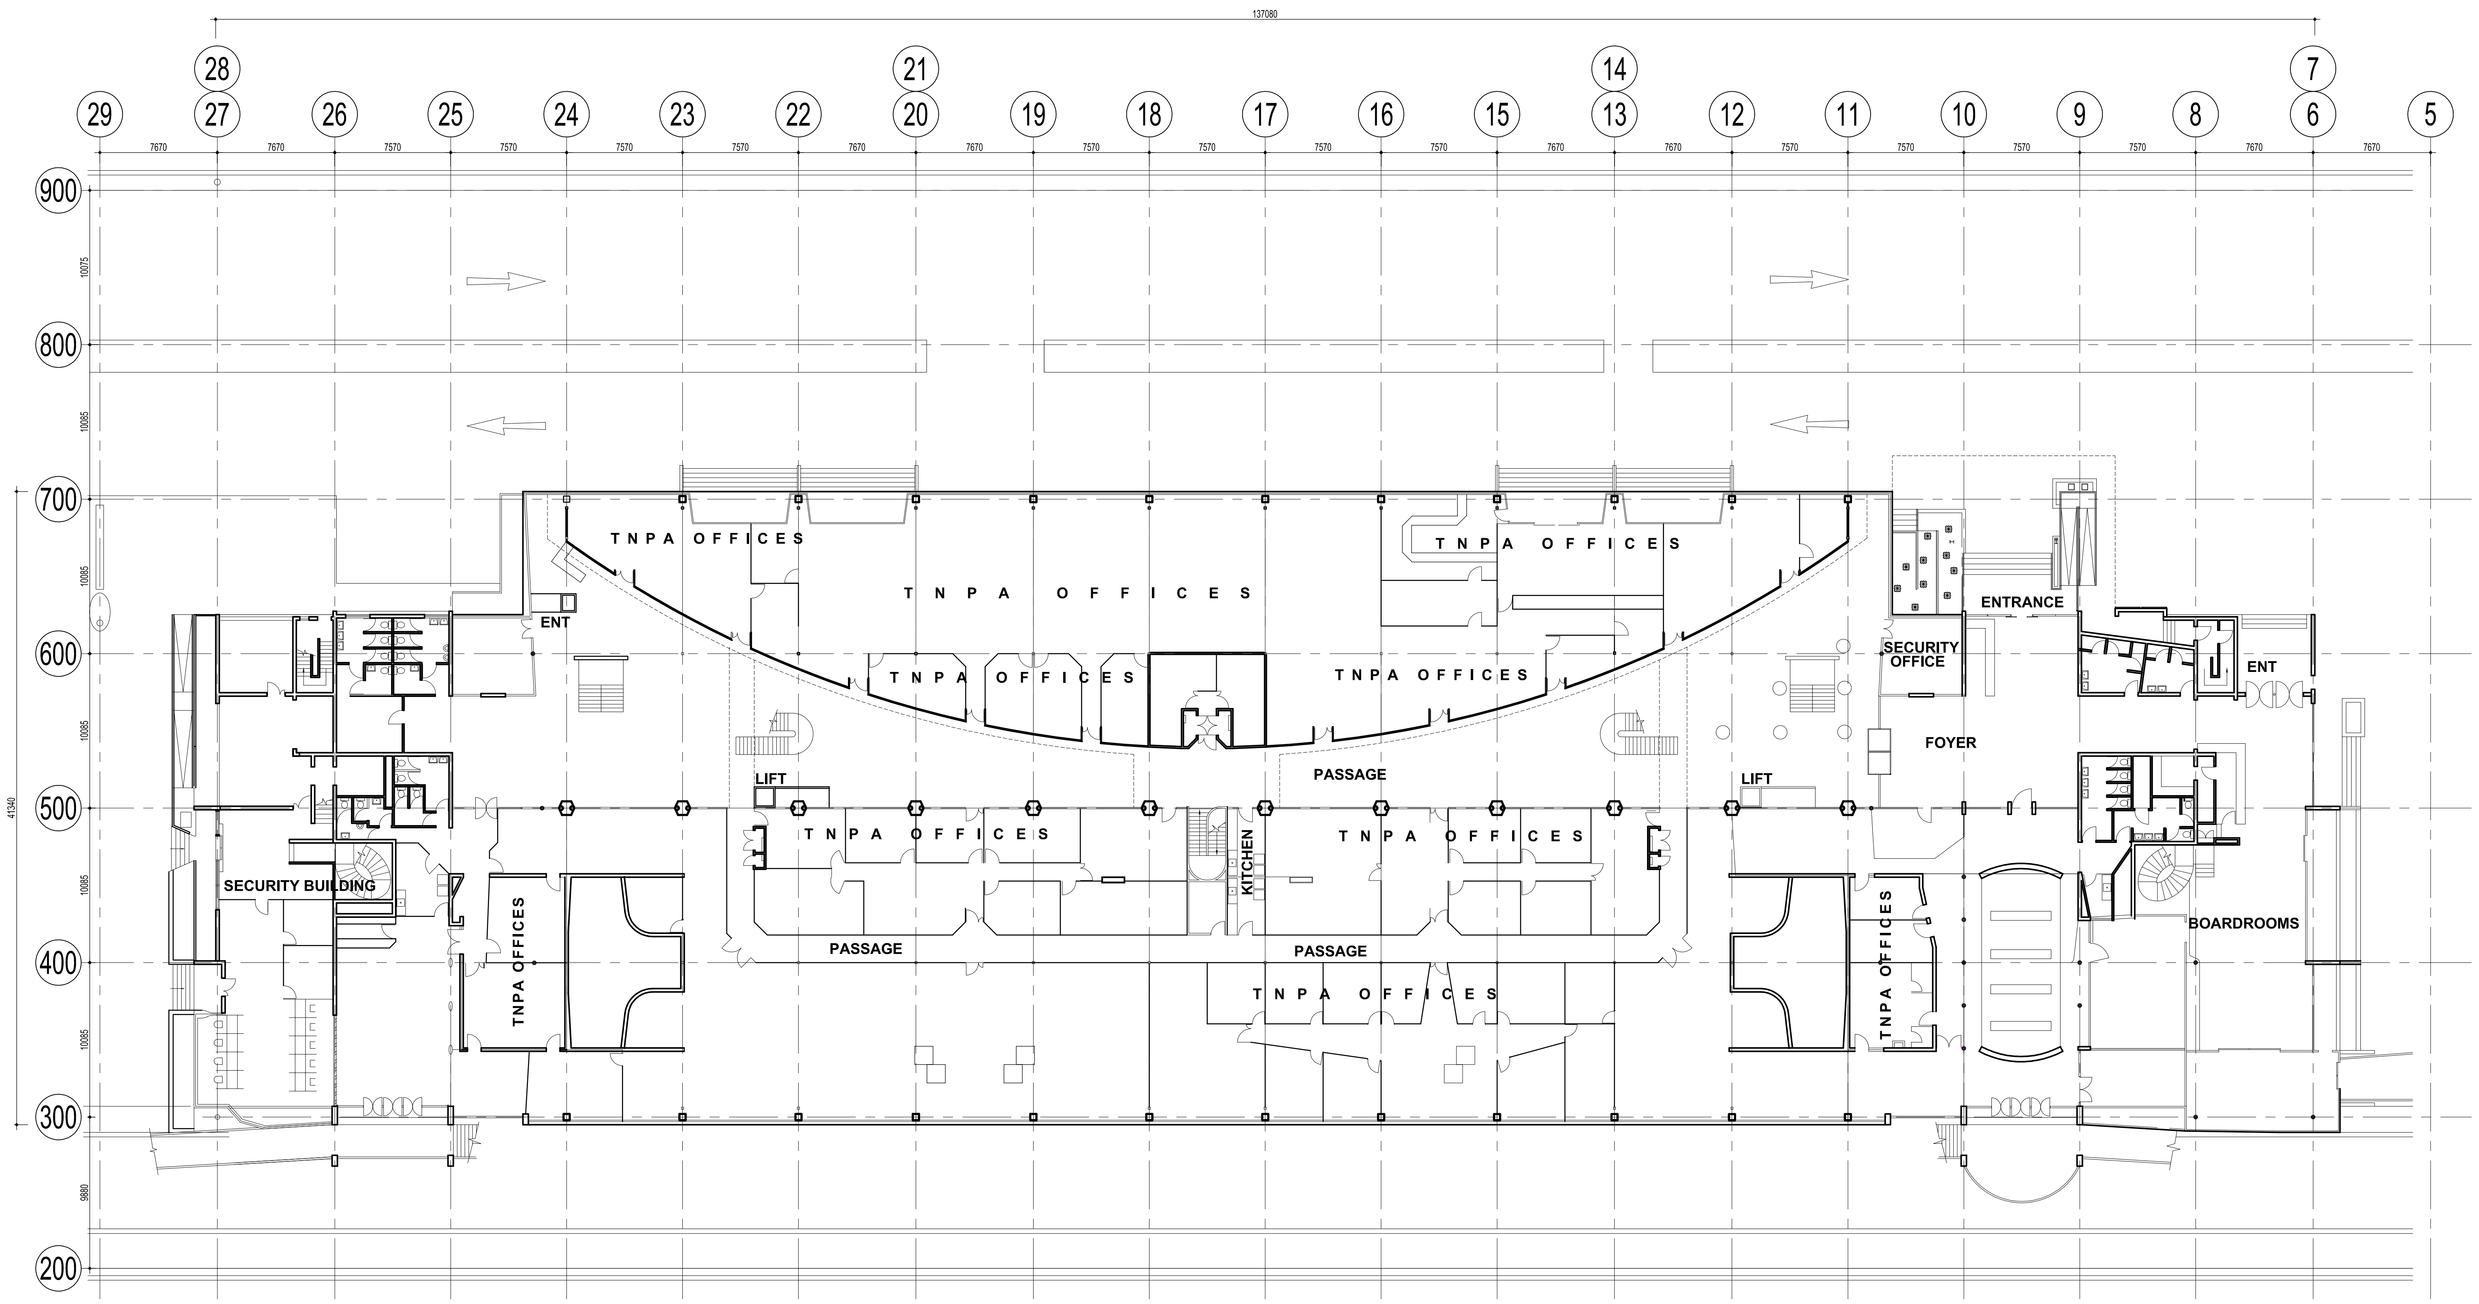

GROUND FLOOR PLAN
SCALE 1 : 200

NOTES

1. DO NOT SCALE DRAWING - ONLY DIMENSIONS SHOWN TO BE USED.

2. THE CONTRACTOR SHALL VERIFY ALL CONDITIONS, DIMENSIONS AND LEVELS ON THE SITE AND NOTIFY THE NEC SUPERVISOR OF ANY VARIATIONS BEFORE CONSTRUCTION.

DRAWING NO.	REFERENCE

REFERENCE DRAWINGS

APPLICATION FOR AMAFA APPROVAL

NO.	DESCRIPTION	BY	CHKD	APPD	DATE
00	Issued for	SwS	SQ	TQ	02/10/2020

REVISIONS

This Document including all design and information therein is Confidential Intellectual Property of Transnet.Copyright and all other rights are reserved by Transnet. This Document may only be used for its intended purpose.

CONTRACTOR / CONSULTANT			
TITLE	NAME	SIGN	DATE
	.		. . .
	.		. . .
	.		. . .
	.		. . .
	.		. . .
	.		. . .
	.		. . .
	.		. . .

OPERATING DIVISIONS			
TITLE	NAME	SIGN	DATE
	.		. . .
	.		. . .
	.		. . .
	.		. . .
	.		. . .
	.		. . .
	.		. . .
	.		. . .

TRANSNET GROUP CAPITAL			
TITLE	NAME	SIGN	DATE
DRAWN	AN		09 12 2020
CHECKED	RS		09 12 2020
DESIGNED	.		. . .
CHECKED	.		. . .
.	.		. . .
.	.		. . .
PR.ENG. / PR.TECH./PR. ARCH			
NAME	N.A. NAGAN		DATE
SIGNATURE			09 12 20
REG. NUMBER	ST 0276		
SCALE :	AS SHOWN		A0

TRANSNET LTD : REG. NO. 1990/000900/30
237 MAHATMA GANDHI ROAD
DURBAN
P.O. BOX 31683, DURBAN
TEL: 031 361 1696
FAX: 0866 770815

TRANSNET national ports authority

PORT OF DURBAN
T JETTY
CAR TERMINAL EXPANSION
CONVERSION OF OCEAN TERMINAL BUILDING TO CAR TERMINAL ADDITIONAL PARKING
LOWER GROUND & GROUND FLOOR PLAN

PROJECT NUMBER	OD	FBS	DIS	TYPE	DRAWING NO.	SHEET	REV	ID
OTBEXPN1	000		A	LA	0001	01	01	TD