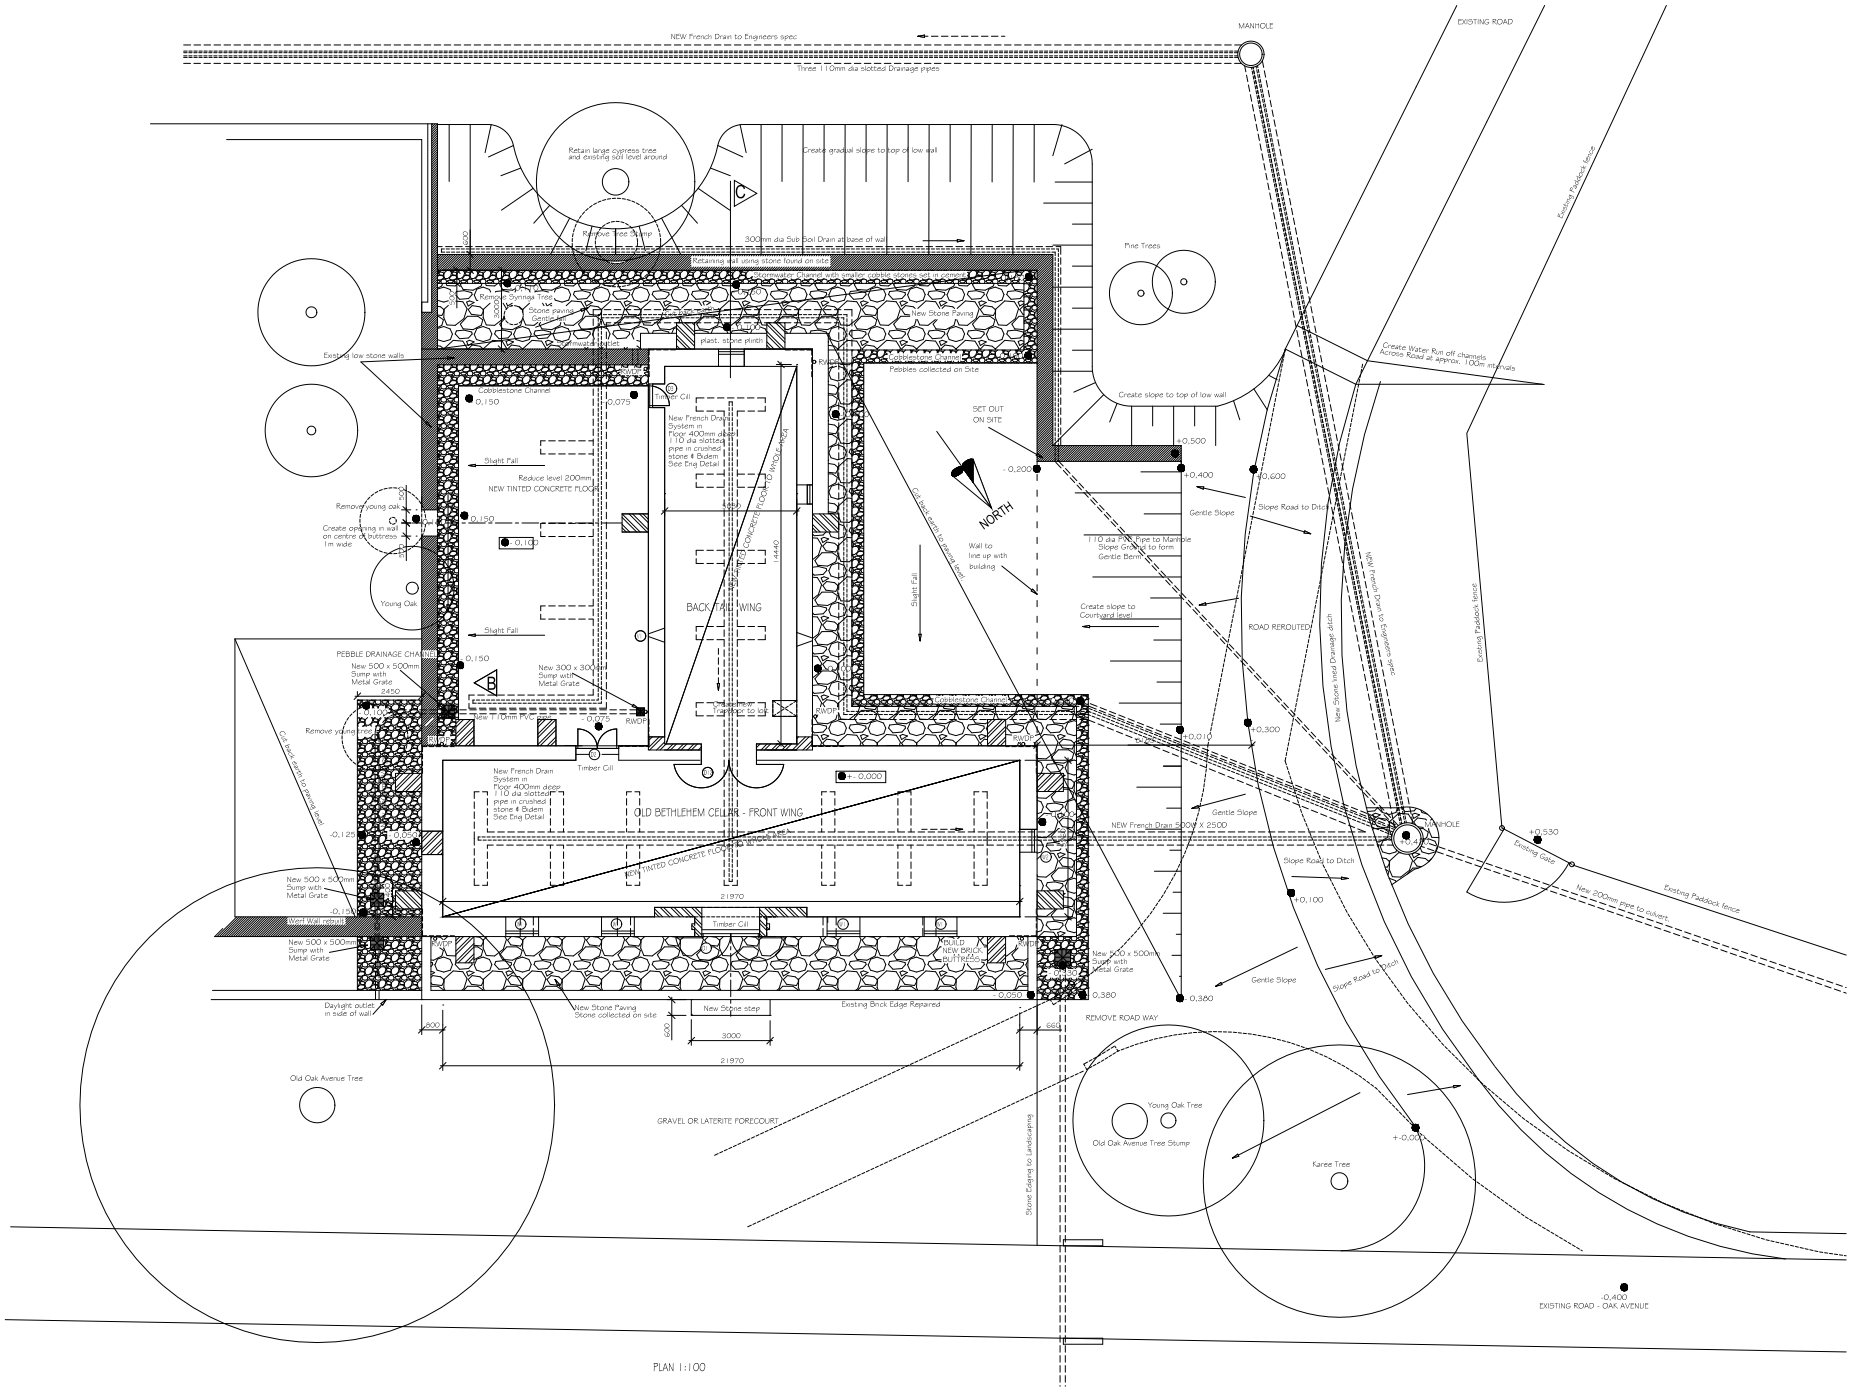

PLAN 1:100

WINE CELLAR EXTERNAL WORKS - NOTES

ALL MEASUREMENTS TO BE CHECKED ON SITE.

OWNERS SIGNATURE: _____

ARCHITECTS SIGNATURE: _____

DATE	REVISIONS	No.
14/08/2012	ISSUED FOR SITE DISCUSSION AND SETTING OUT	0
NOV 2012	ISSUED FOR CONSTRUCTION	1
20/5/2013	AS BUILT DRAWING FOR SAHRA	6

ELISABETH DAVIES ARCHITECT

4 JAMES BARRY AVE
CONSTANTIA CAPE TOWN 7800

tel (021) 794 2361
fax (021) 794 8824
email lizarc@mweb.co.za

OLD BETHLEHEM FARM

RESTORATION OF WINE CELLAR

1:100 WINE CELLAR - EXTERNAL WORKS

Project No:	Drawing No:	Revision:
OB/12	WD 003	6

Date: FEBRUARY 2013	Drawn by: LIZ DAVIES
Scale: 1:100	Designer: LD