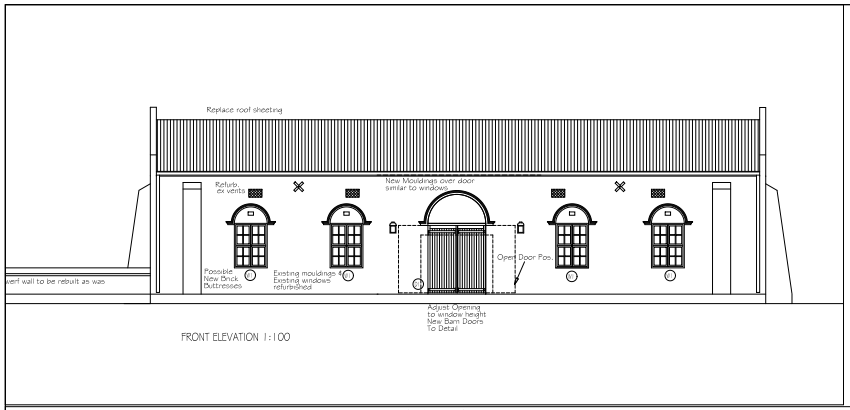

FRONT ELEVATION 1:100

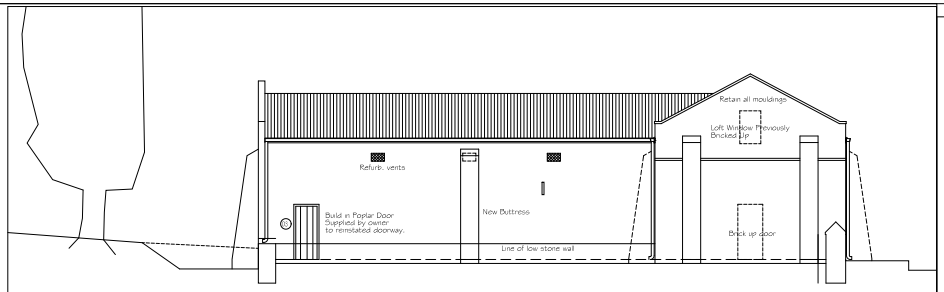

EAST ELEVATION 1:100

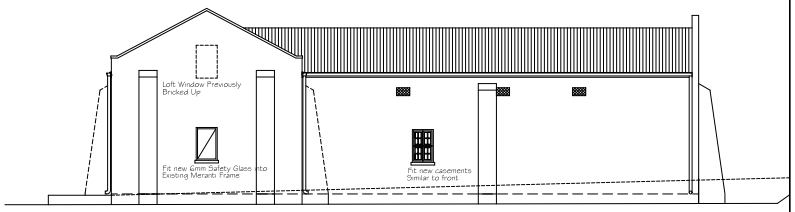

WEST ELEVATION 1:100

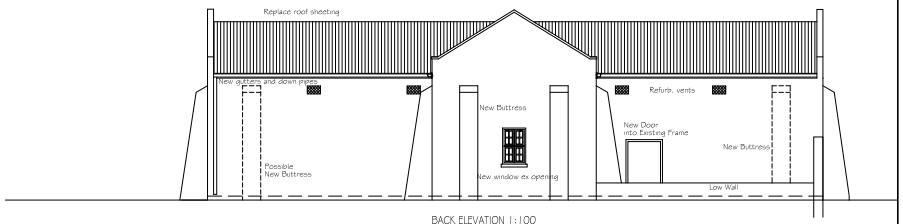

BACK ELEVATION 1:100

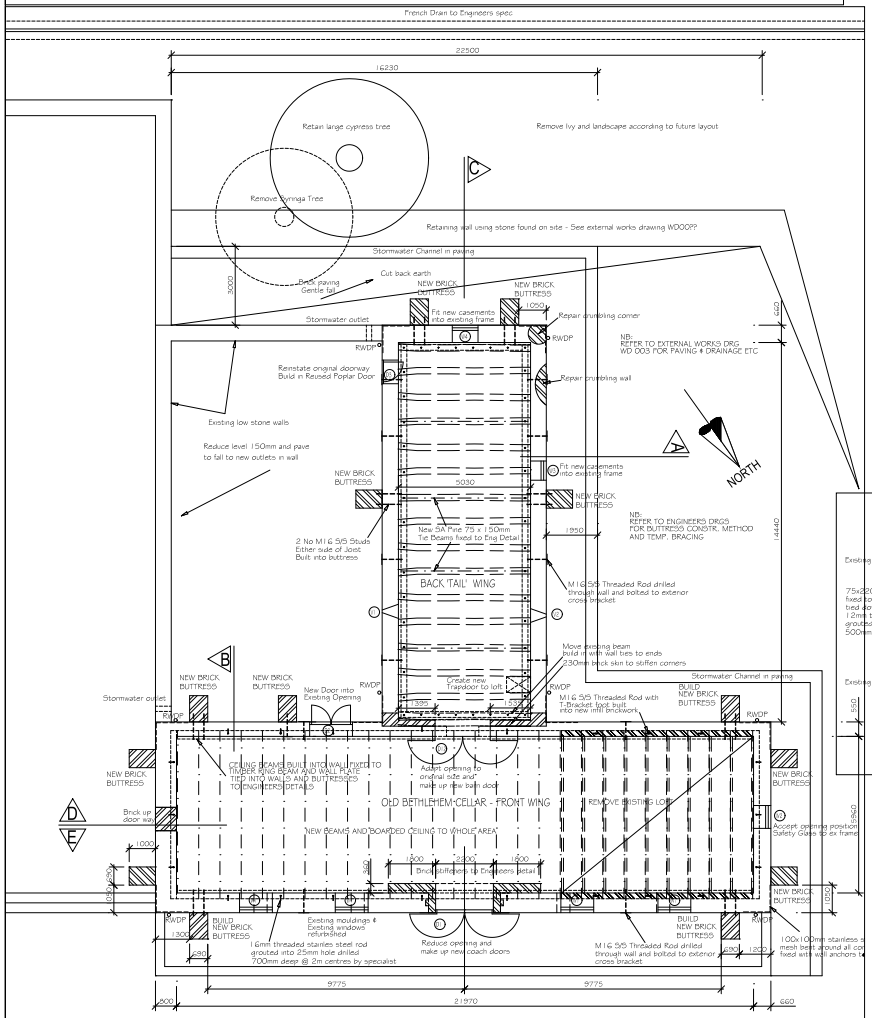

PLAN 1:100

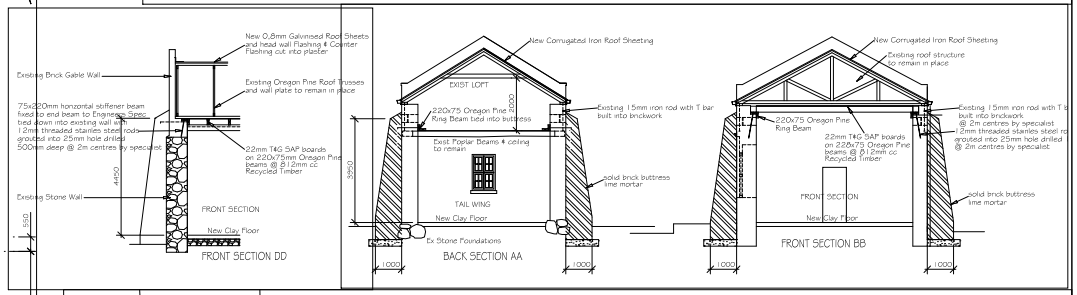

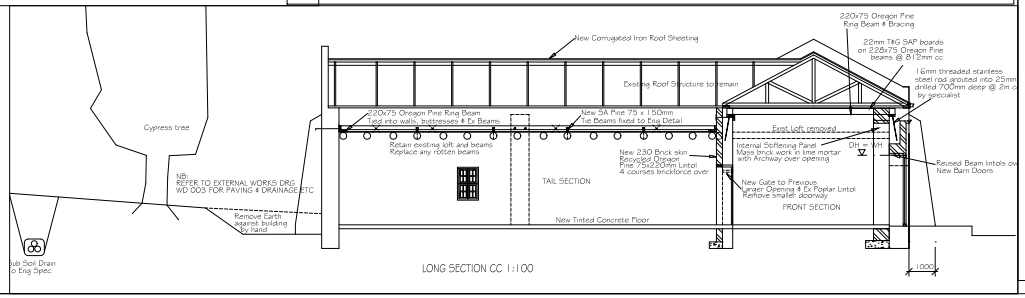

LONG SECTION CC 1:100

WINE CELLAR - SHORT SPECIFICATION

BUTTRESSES - Foundations Concrete to Eng Spec
Underburn Brick Masonary with Lime Mortar
Plastered with Lime Plaster and Lime washed

MASONARY REPAIRS - 'Underburn' Stock Bricks in Lime Mortar
Plastered with Lime Plaster and Lime washed

ROOFING - Heavy Guage Long span Corrugated iron Sheeting, Galvanized and Painted Silver OR Grey
Lapped to lee of Wind, Sealed with Lap seal and Poly closers to ends.

HEAD FLASHING - Galvinized Flashing and Counter Flashing, cut into plaster and sealed
Lapped to lee of Wind, Sealed with Lap seal and Poly closers to ends.

CEILING - recycled Oregon Pine Beams and boards
FINISH - Cleaned and left as is

FLOOR FINISH - Clay Floor using local materials
Method to be determined

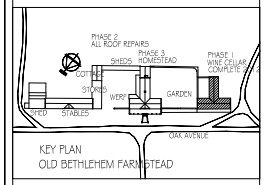

KEY PLAN
OLD BETHLEHEM FARMSTEAD

OWNERS SIGNATURE: _____

ARCHITECTS SIGNATURE: _____

DATE	REVISIONS	No.
6/03/2012	ISSUED FOR CLIENT APPROVAL	0
4/04/2012	TIMBER RING BEAM & BRICK BUTTRESS REVISED	1
17/04/2012	TIMBER & BUTTRESSES REV. REINFORCED PLASTER ADDED	2
23/04/2012	UPDATED TO ENGINEERS PLANS, CEILING RAISED	3
7/05/2012	FOR CONSTRUCTION	4
20/07/2012	EAVES DETAIL, CORNER MESH, REVISED HWC	5
1/07/2012	BRICK DIMS ADDED, RING BEAM FIXINGS	6
20/05/2013	As Built Drawings Submitted to SAHRA	7

ELISABETH DAVIES ARCHITECT

4 JAMES BARRY AVE
CONSTANTIA CAPE TOWN 7800

tel (021) 794 2361
fax (021) 794 8824
email lizarc@mweb.co.za

OLD BETHLEHEM FARM
RESTORATION OF
WINE CELLAR

PLAN, SECTIONS AND ELEVATIONS

Project No:	Drawing No:	Revision:
OB/12	WD 001	7

Date: MARCH 2012	Drawn by: LIZ DAVIES
Scale: 1:100	Designer: LD