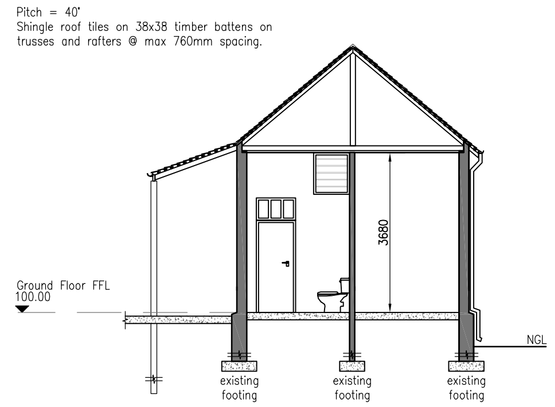

1 Section C-C — BUILDING A
SCALE – 1 : 100

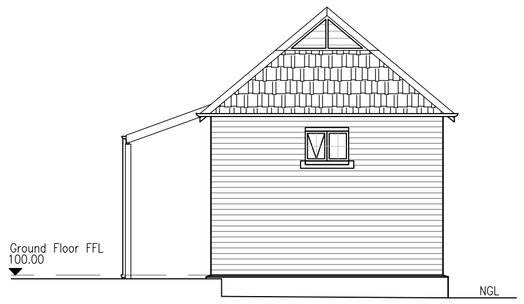

1 Elevation
SCALE – 1 : 100

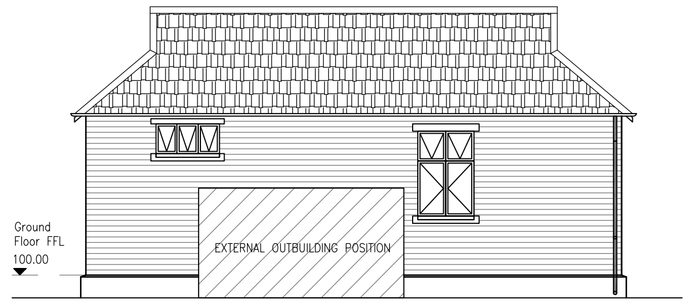

1 Elevation
SCALE – 1 : 100

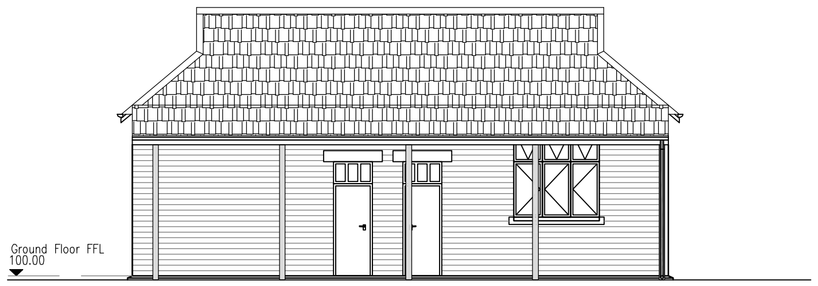

1 Elevation
SCALE – 1 : 100

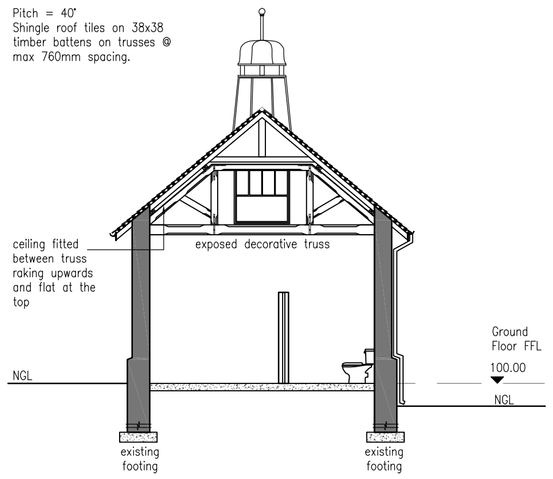

1 Section D-D — BUILDING B
SCALE – 1 : 100

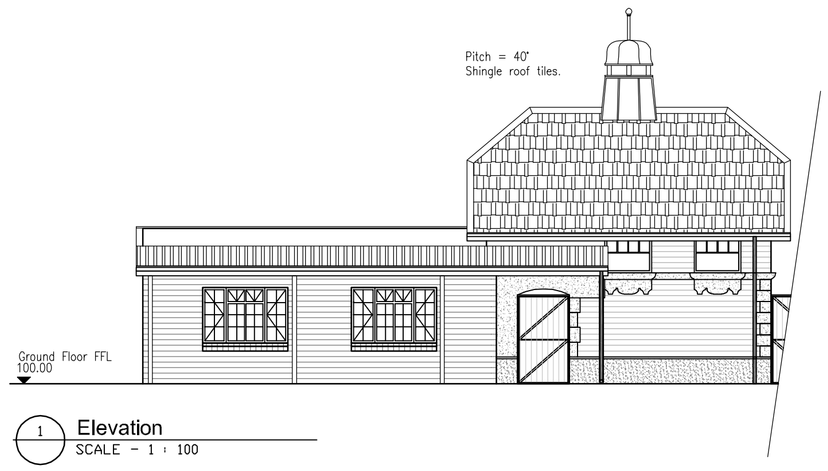

1 Elevation
SCALE – 1 : 100

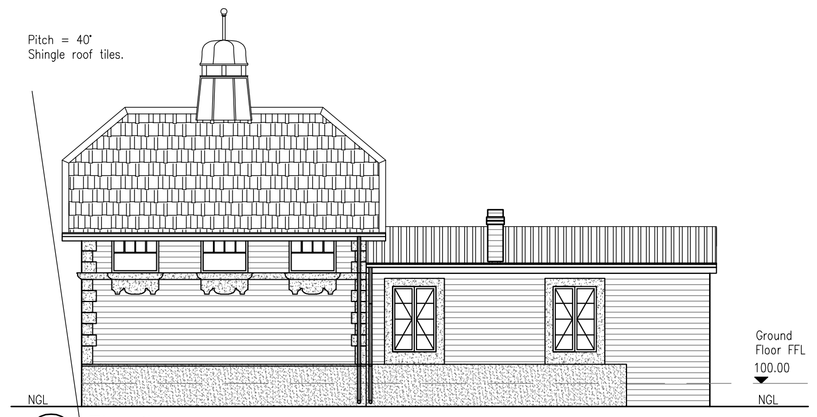

1 Elevation
SCALE – 1 : 100

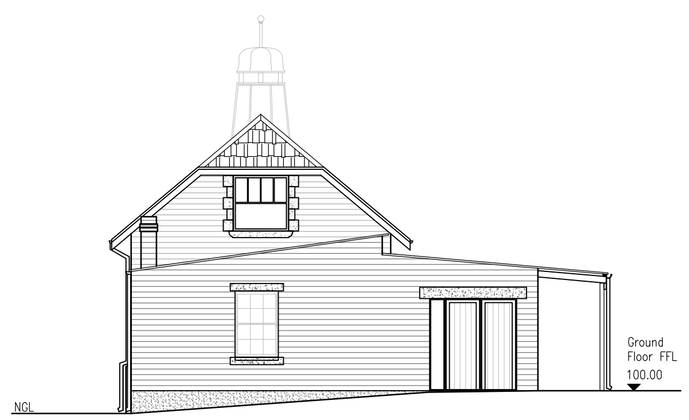

1 Elevation
SCALE – 1 : 100

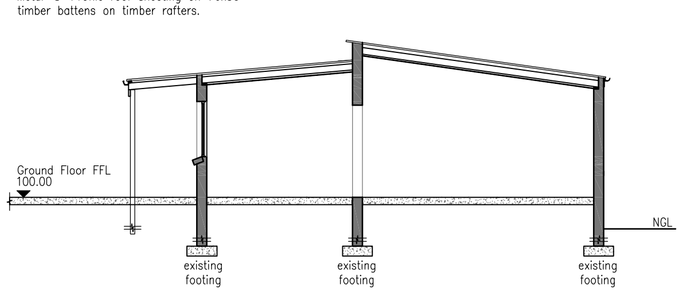

1 Section E-E — BUILDING C
SCALE – 1 : 100

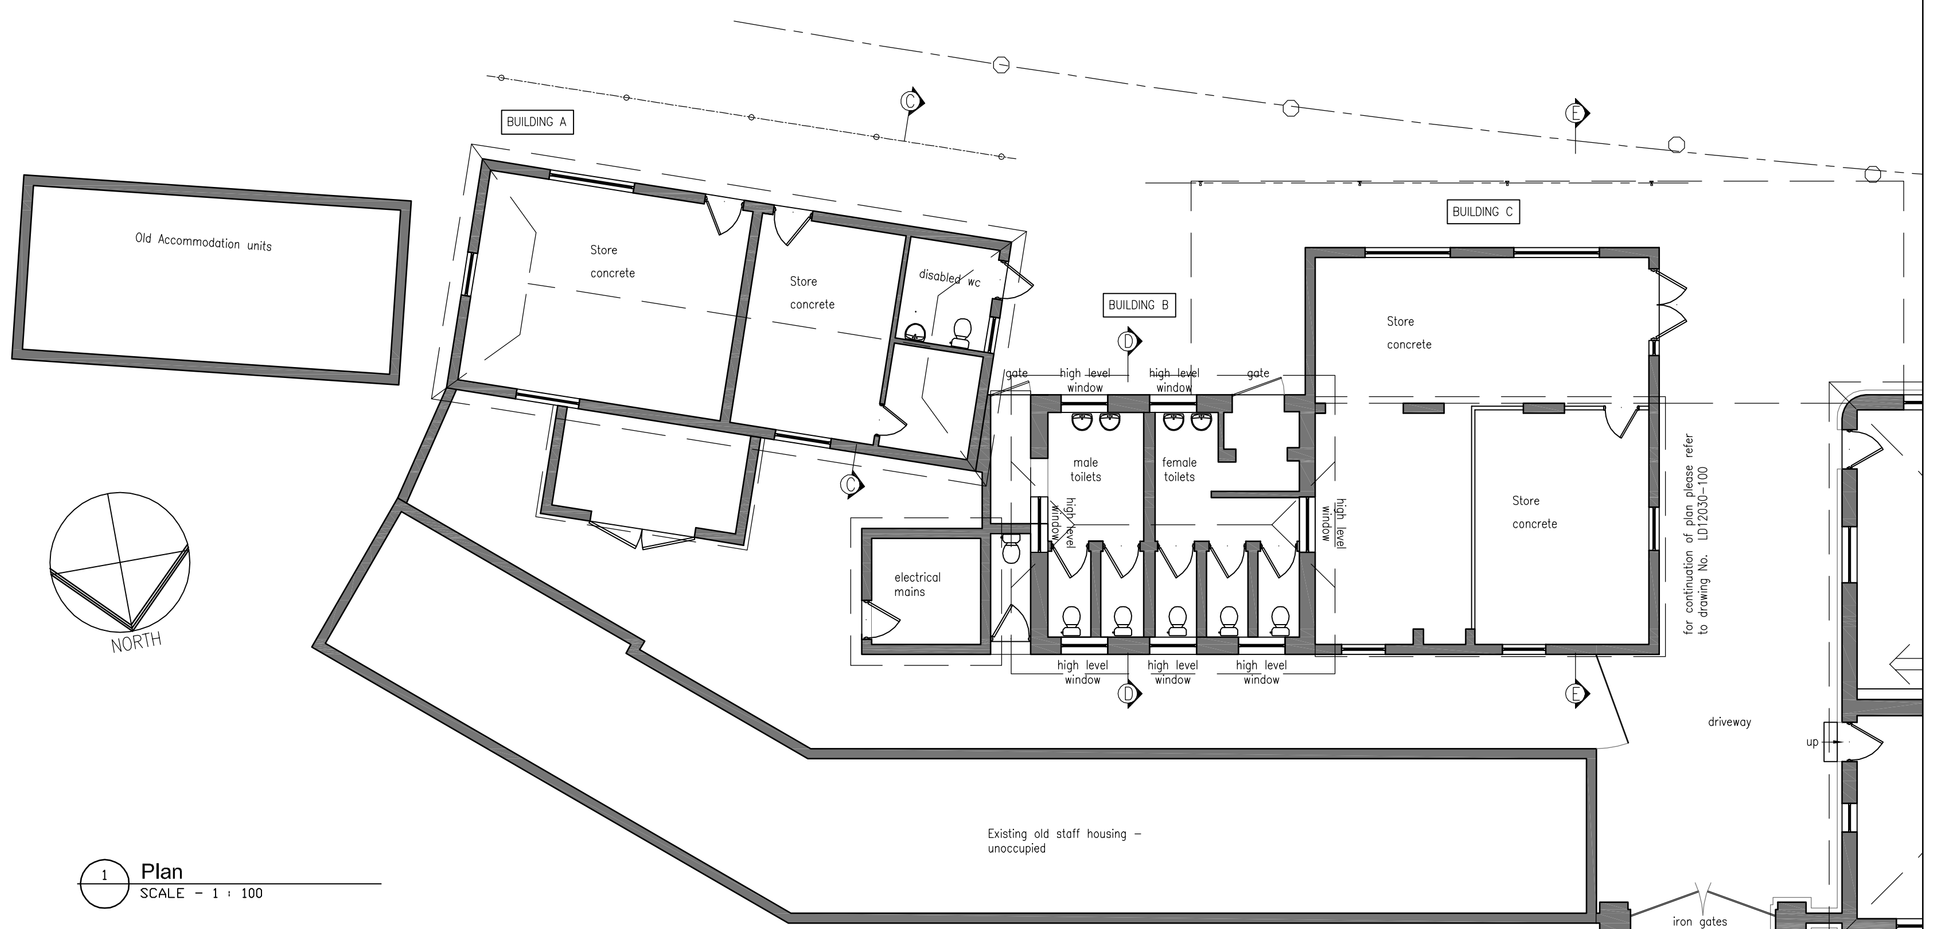

1 Plan
SCALE – 1 : 100

ALL DIMENSIONS TO BE CHECKED ON SITE PRIOR TO ANY WORK OR SHOP DRAWINGS. ALL DISCREPANCIES TO BE DISCUSSED WITH PROJECT MANAGER PRIOR TO IMPLEMENTATION THEREOF.

REVISION

No.	DATE	DESCRIPTION	INITIAL

prasa
PASSENGER RAIL AGENCY OF SOUTH AFRICA

SIGNATURE DATE

SAKHISIZWE ARCHITECTS INTERIORS

41 SWAPO (BROADWAY), DURBAN NORTH
PRIVATE BAG X12 GATEWAY 4321
EMAIL: info@sakhisizwearchitects.co.za
TEL : 031 563 3424 FAX: 031 563 3518

Suite 2b GOLDEN PENNY CENTRE
26 HELY HUTCHINSON STREET, MTUNZINI
EMAIL: mark@sakhisizwearchitects.co.za

Project Title:

PROPOSED ALTERATIONS TO PIETERMARITZBURG STATION FOR PRASA

date : APRIL 2012	scales : 1 : 100
drawn : -	

Drawing Description:

COUNCIL SUBMISSION DRAWING

STATION ANCILLARY BUILDINGS PLAN, SECTIONS , ELEVATIONS

AS BUILT DRAWING

Job No.	Drawing No.	Rev. No.
s282.3	104	-

ISSUED FOR APPROVAL	
ISSUED FOR INFORMATION	
ISSUED FOR SUBMISSION	11.02.2013
ISSUED FOR TENDER	
ISSUED FOR CONSTRUCTION	