P.T.O.

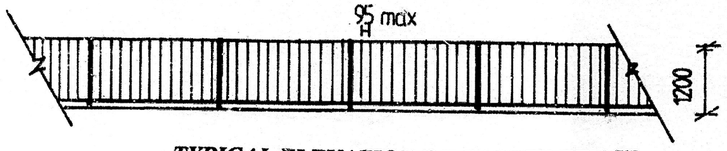

TYPICAL ELEVATION OF SAFETY FENCE

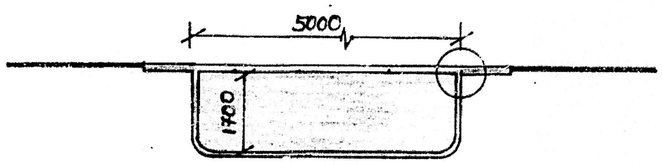

SECTION A:A

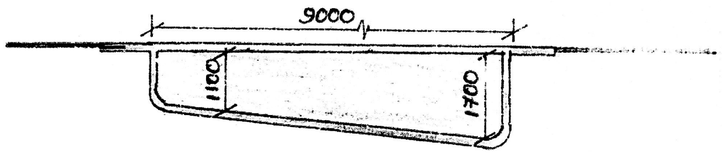

SECTION B:B

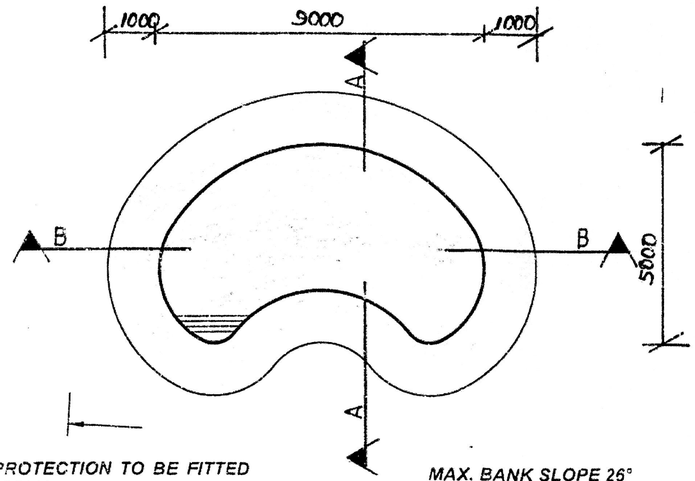

PLAN

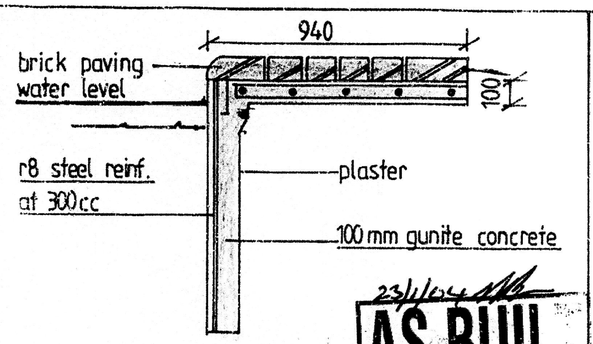

RING BEAM DETAIL

AS BUILT

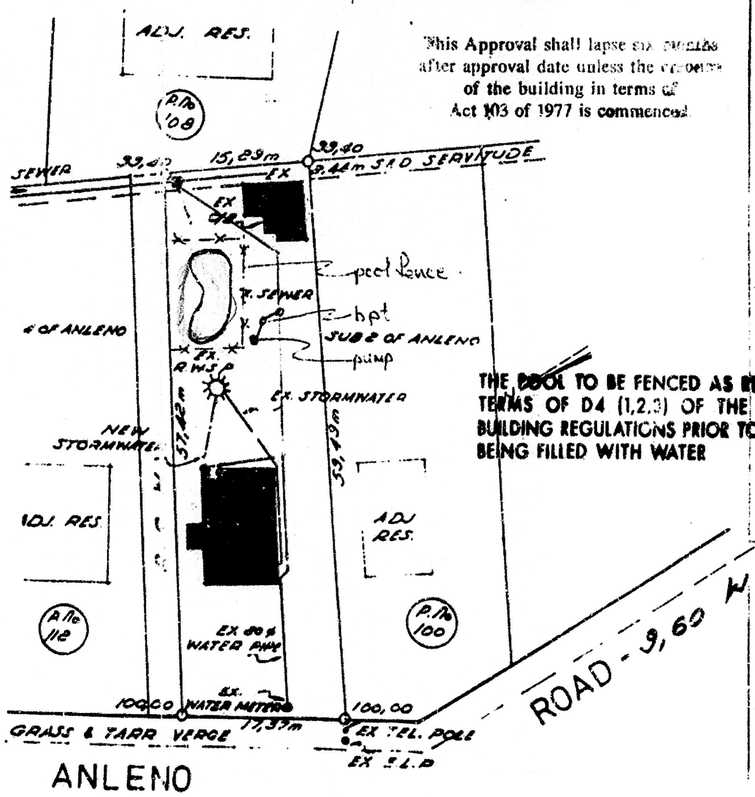

SITE PLAN

This Approval shall lapse six months after approval date unless the erection of the building in terms of Act 103 of 1977 is commenced

THE POOL TO BE FENCED AS REQUIRED IN TERMS OF D4 (1,2,3) OF THE NATIONAL BUILDING REGULATIONS PRIOR TO THE POOL BEING FILLED WITH WATER

SHEET 1/1 COPY

ETHEKWINI MUNICIPALITY
CENTRAL
Plan No: 43 11 03

APPROVED in terms of The National Building Regulations and Building Standards Act No. 103 of 1977

-6 NOV 2003 _____
DATE LOCAL AUTHORITY

This Plan is approved on the basis of the information shown hereon. Attention is drawn to attached documentation.

IMPORTANT

THE APPLICANT IS RESPONSIBLE FOR ASCERTAINING THE POSITION OF ALL POST OFFICE CABLES OR OTHER PLANT AND WILL BE LIABLE FOR ANY COST ARISING DUE TO DAMAGE TO OR THE NEED FOR RELOCATION OF SUCH PLANT ARISING OUT OF WORK INDICATED ON THIS APPLICATION.

MIKE SYDNEY & ASSOCIATES cc.
CK 91/01332/23
CONSULTING CIVIL & STRUCTURAL ENGINEERS
19 LINNET ROAD TELEPHONE:
WOODHAVEN 4001 (031) 4629621

LOT 3 OF 8TH OF SEAVIEW
TEL 4620736

PROPOSED SWIMMING POOL FOR R.NAIDOO AT 104 ANLENO ROAD – ~~LOT 3 of ANLENO of ABIKLNO of SEAVIEW 845~~

RATE NO:40939057

DRAWN : MED.POOLS
P.O.BOX 39095
QUEENSBURGH
4070

SCALES 1/100 : 1/500

EARTH LEAKAGE PROTECTION TO BE FITTED TO ELECTRICAL SUPPLY.
PRECAUTION TO BE TAKEN IN REGARD TO CONDENSATE.
PUMP CHAMBER TO BE ADEQUATELY DRAINED.
ELECTRICAL EQUIPMENT TO BE HOUSED.
WASTE WATER TO BE DISCHARGED INTO OPEN CHANNEL MH VIA B P T.
EXCESS SOIL TO BE REMOVED FROM SITE.

MAX. BANK SLOPE 26°
ANY VARIATIONS IN GROUND CONDITIONS OR DETAILS AS SHOWN ON THIS DWG. THE ENG. TO BE NOTIFIED.

POOL SECURITY FENCE WITH SELF LOCKING SELF CLOSING GATE TO S.A.B.S. 1390 FITTED TO POOL AREA AS SHOWN ON PLAN, TO COMPLY WITH N.B.R. FENCE AND GATE TO BE POSITIONED BY OWNER