AS BUILT
FIRST PLAN
SCALE 1:100

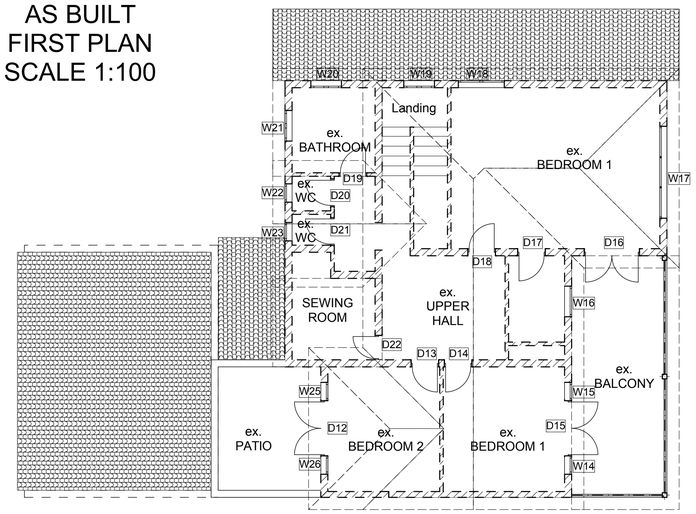

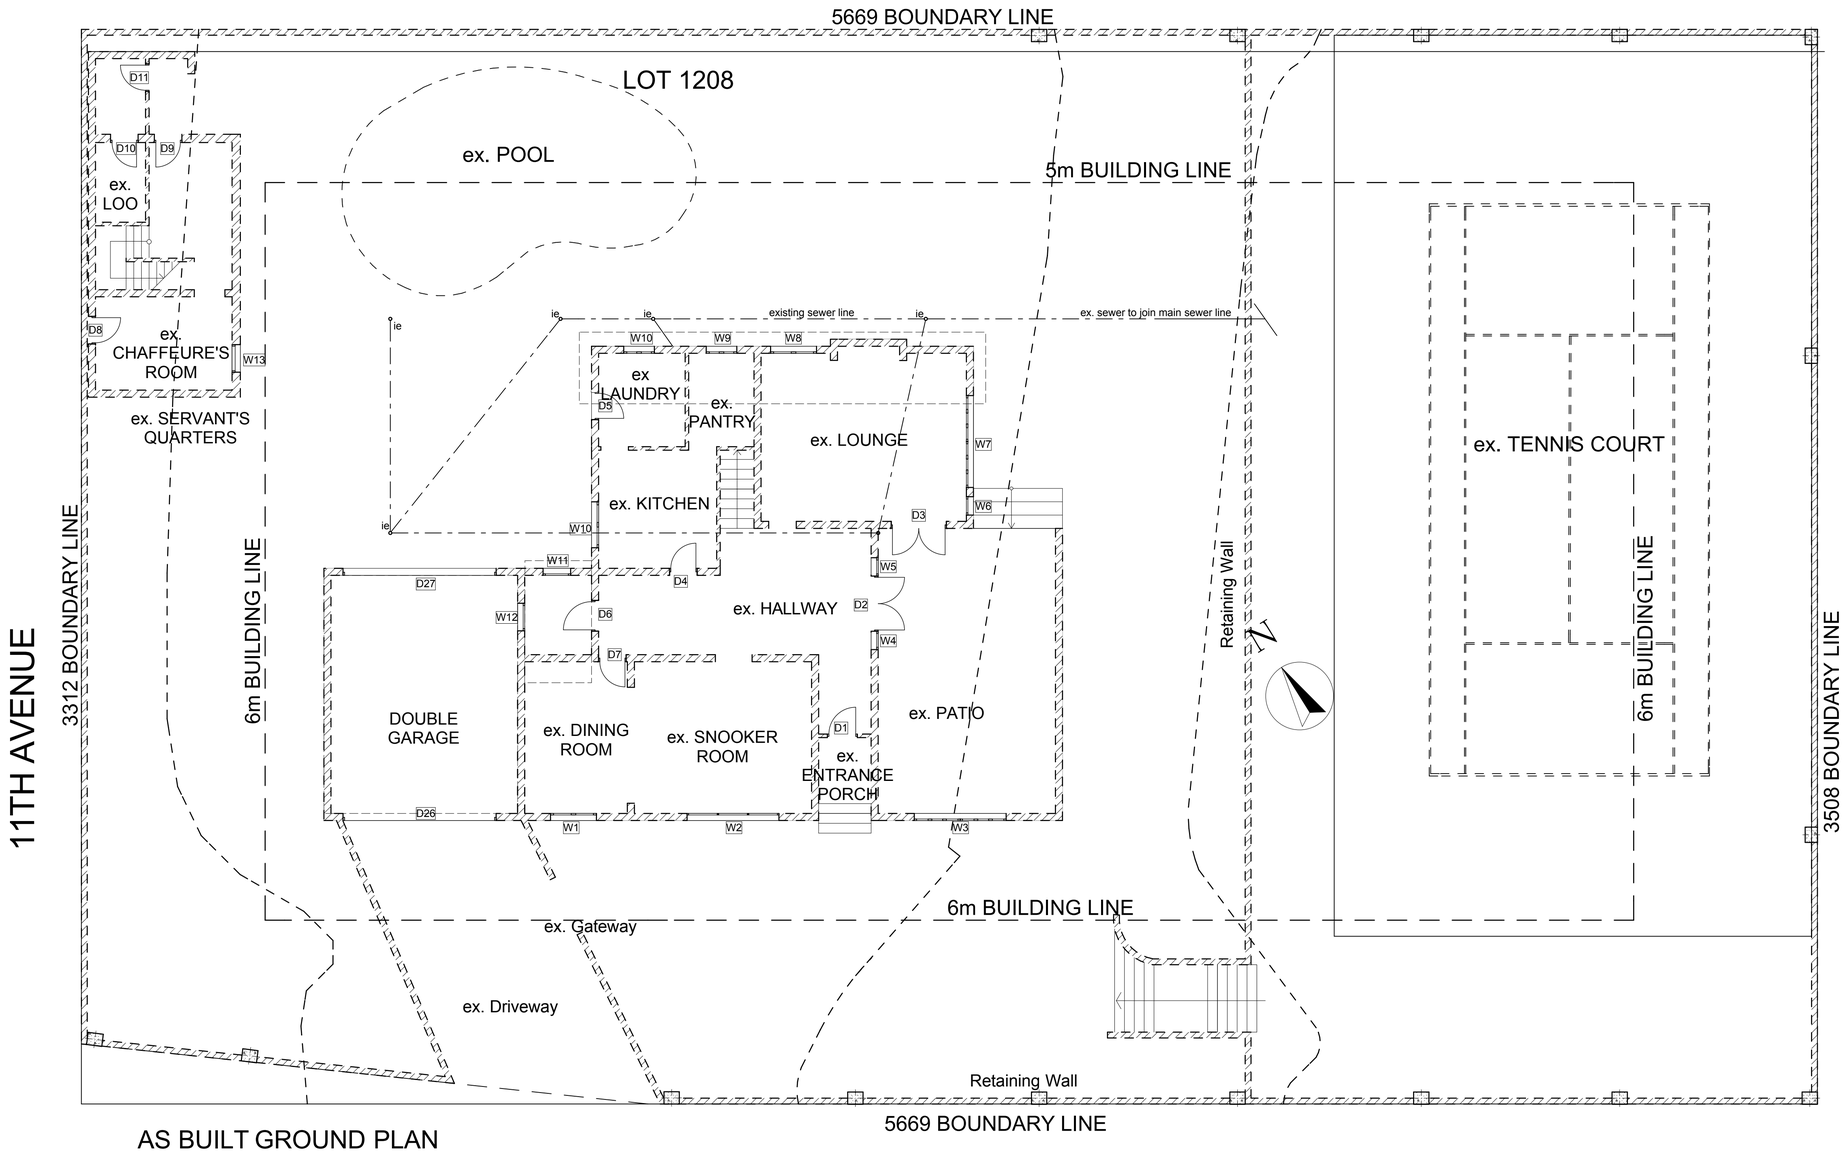

AS BUILT GROUND PLAN
SCALE 1:100

GLADYS ROAD

ALL DIMENSIONS ARE INDICATED IN MILLIMETRES AND MUST BE CONTROLLED ON SITE. THIS DRAWING MUST NOT BE SCALED;
ONLY FIGURED DIMENSIONS MAY BE USED.

NAME	ADRESS / PROPERTY DESCRIPTION	SIGNATURE

OWNER'S SIGNATURE

AUTHOR'S SIGNATURE

REGISTRATION NUMBER
T1119
QHAKAZA AFRICA CONSULTING (Pty) Ltd

QHAKAZA AFRICA CONSULTING

14 FISHER STREET
DURBAN 4001
DURBAN, KWAZULU NATAL
SOUTH AFRICA, 4001
(T)031 337 1565(F) 086 695 9810
(e)mandisa@qhakazaafrica.co.za

325 ON COWEY ROAD

PROJECT DESRIPTION:

PROPOSED DEMOLITION OF EXISTING BUILDING AT 325 PROBLEM MKHIZE ROAD,ERF 1207,MORNINGSIDE FOR ON SUCCESS TRADING CC.

RATE NUMBER :

DRAWING STAGE :
SUBMISSION DRAWINGS

DRAWING TITLE :
AS BUILT FLOOR & SITE PLAN

SCALE : 1:100	DATE : MARCH 2013
DRAWN : P.N	JOB No: 2013 / 004
QAC CHECKED: N N	DATE CHECKED :
SI CHECKED: M.D	DATE CHECKED:
DRAWING NUMBER : 2013 / 004 / 01	REVISION NO. 0