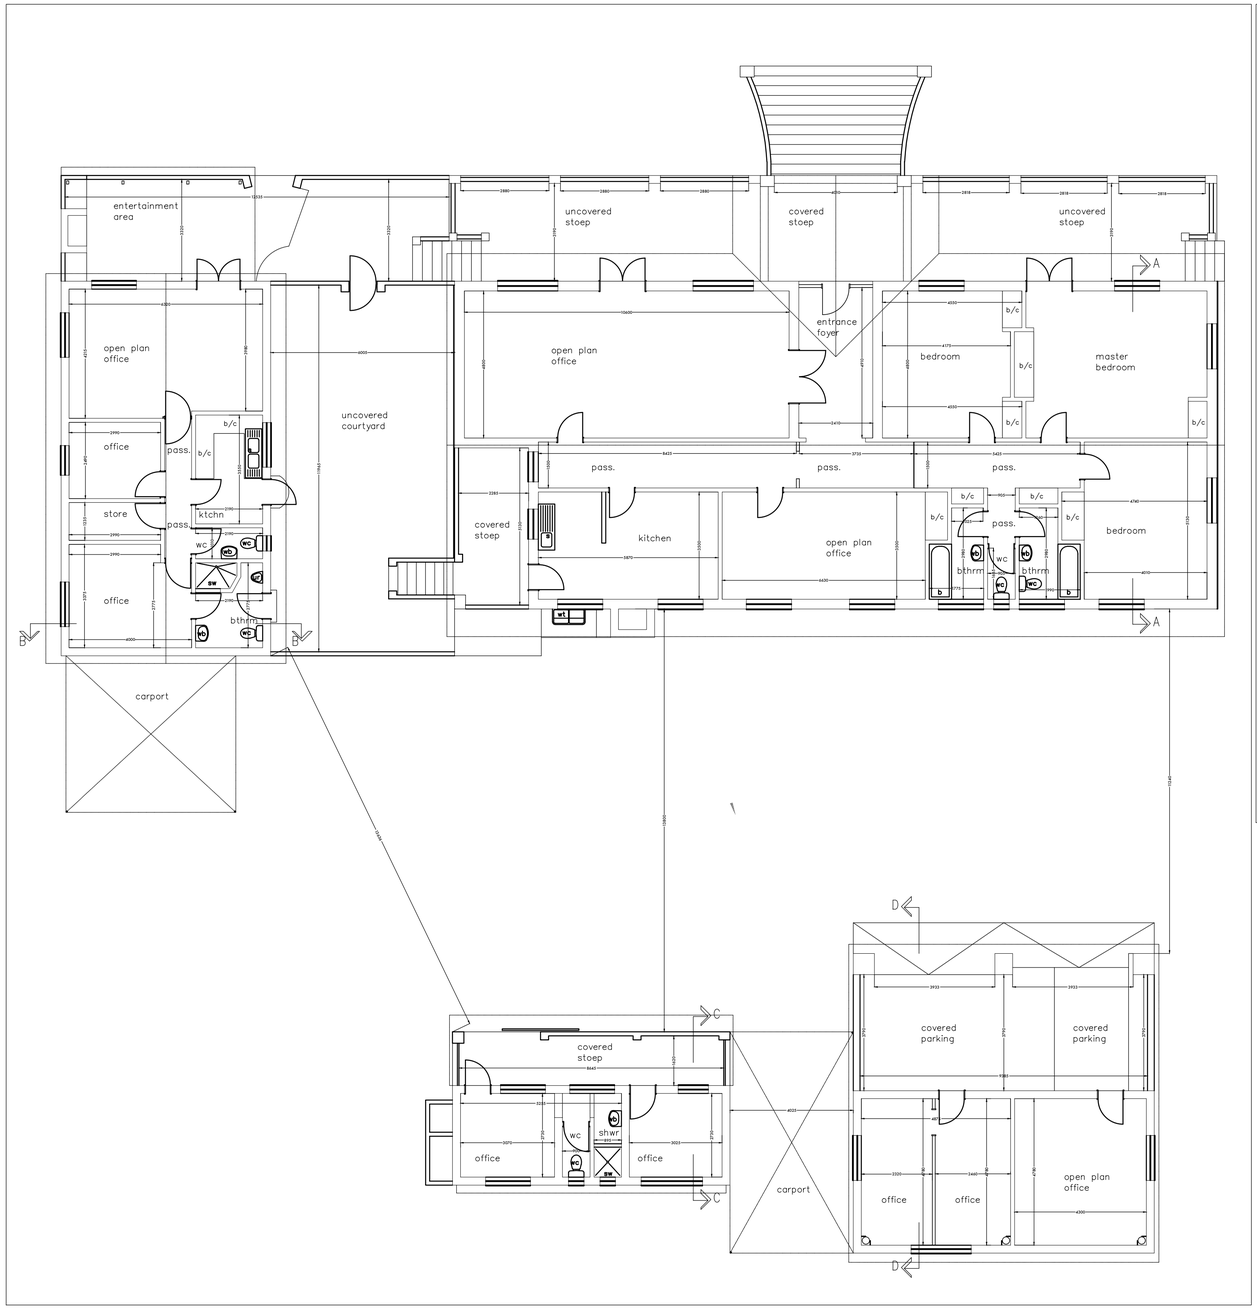

Site Plan and Ground floor plan

1:100

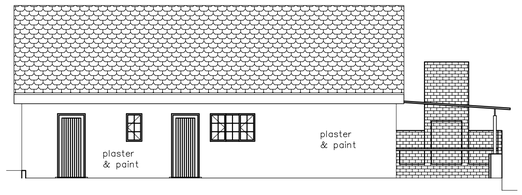

EASTERN ELEVATION

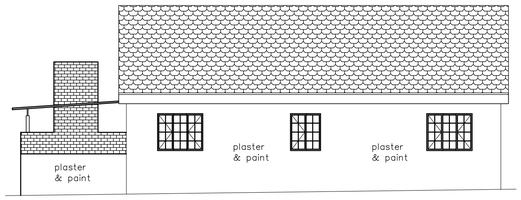

WESTERN ELEVATION

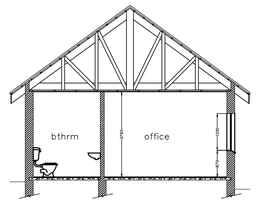

SECTION B–B

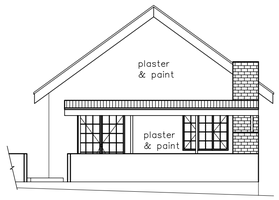

NORTHERN ELEVATION

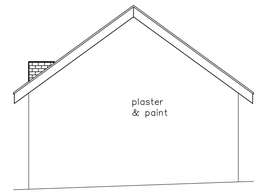

SOUTHERN ELEVATION

Annex to Main Residence

1:100

WIEW ARCHITECTS

ARCHITECTURE
ARBITRATION
HERITAGE
INTERIOR

PROJECT NAME:

Phase II Heritage Assessment of the existing structures on portion 662 of the Farm Olievenhoutpoort 196IQ

DRAWING TITLE:

As-built drawings

SCALE:	VARIES
DRAWN:	EW
DATE:	2017-06-28
STATUS:	AS-BUILT
JOB NO:	WIEW_0143
DRAWING NO:	

WIEW143_001

REV 0

COPY RIGHT RESERVED ON THE CONTENTS OF THIS DRAWING